

**IOSCO COUNTY REMONUMENTATION  
LAND CORNER RECORDATION CERTIFICATE  
Filing Requirement of Act 74, Mich. P.A. 1970**

9 9 185 50

For corners in

Iosco	Located In:	Corner Code #
<small>(County)</small>		
1. Public Land Survey	T 21NR 6E	<u>M-7</u>
	T 21NR 7E	<u>A-8</u>
	T ___ R ___	_____
	T ___ R ___	_____
2. Property Controlling in Section	S ___ T ___ R ___	_____
	S ___ T ___ R ___	_____
3. Miscellaneous Property in Sec.	S ___ T ___ R ___	_____
	S ___ T ___ R ___	_____

STATE OF MICHIGAN  
IOSCO COUNTY  
FILED

20 DEC 99 10:13 A.M.

RONITA M. COYLE  
REGISTER OF DEEDS

**Register of Deeds Stamp & File Number**

4. Lot No. \_\_\_\_\_, Recorded Plat \_\_\_\_\_

5. Private Claims \_\_\_\_\_

	A	B	C	D	E	F	G	H	I	J	K	L	M
1													
2	6			5		4		3		2		1	
3													
4	7			8		9		10		11		12	
5													
6	18			17		16		15		14		13	
7													
8	19			20		21		22		23		24	
9													
10	30			29		28		27		26		25	
11													
12	31			32		33		34		35		36	
13													

I, JAMES H. GRANGER, in a field survey on November, 1999 do hereby state that under requirements of P.A. 74, Michigan P.A. of 1970, the corner points mentioned in lines 1 and 2 above were in conformance with regulations and rules therefore as required in the current manual of survey instructions of the United States Department of the Interior, Bureau of Land Management or by a decree of a Court of Law and /or that the corner points mentioned in lines 3, 4 and 5 above were in conformance with the rules of the Michigan Board of Land Surveyors or by a Decree of a Court of Law; established, re-established, monumented, recovered, found as expressed below:

**NOTE: Not more than 2 corners, all in the same town and range, may be recorded on this certificate.**

**A. Description of original monument and accessories and/or subsequent restoration:**

1837 GLO	Set Wood Post	
Lewis Clawson	11" B. Ash	S75°W 17lks
	15" Y. Birch	N62°W 4lks
1998 Survey	Fd. RR Spike	
James H Granger 16041		

**B. Description of corner evidence found and/or method applied in restoring or reestablishing corner:**


Found RR spike previously identified. Fits well with measurements to ex. corners to E. & W. and GLO Measurements. Accept position as established. Removed RR spike & set 5/8" x 30" rebar & mon. box.

**C. Description of monument for corner and accessories established to perpetuate locating the position of the corner:**

5/8" x 30" rebar w/ Remon Cap in mon. box		
PP	N62°W	111.90' nail & tag 16041
Fence Post	S66°W	73.33' nail & cap 16041
Gate Post	S7°W	49.87' nail & cap 16041
12" Dbl. Maple w/6"		
Aspen Stump Sprout	S52°E	117.50' nail & cap 16041

ACCEPTED BY THE IOSCO COUNTY  
SURVEY PEER GROUP AS THE  
OFFICIAL CORNER UNDER P.A.  
345 OF 1990 AT A MEETING  
HELD ON 10-13-99

*James H Granger*

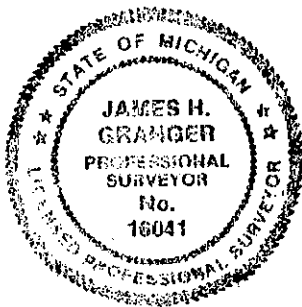

Signed by James H Granger  
Surveyor's Michigan License No. 16041

Date December 14, 1999

REF

APR 21 2000

SECTION