

**IOSCO COUNTY REMONUMENTATION
LAND CORNER RECORDATION CERTIFICATE
Filing Requirement of Act 74, Mich. P.A. 1970**

99-53

For corners in

<u>Iosco</u> (County)	Located In:	Corner Code #
1. Public Land Survey	T <u>21NR 6E</u> T <u>21NR 7E</u> T _____ T _____	<u>M-10</u> <u>A-10</u>
2. Property Controlling in Section	S _____ T _____ R _____ S _____ T _____ R _____	_____
3. Miscellaneous Property in Sec.	S _____ T _____ R _____ S _____ T _____ R _____	_____
4. Lot No. _____, Recorded Plat _____		
5. Private Claims _____		

STATE OF MICHIGAN
IOSCO COUNTY
FILED

20 DEC 99 10:13 A.M.

BONITA H. COYLE
REGISTER OF DEEDS

Register of Deeds Stamp & File Number

	A	B	C	D	E	F	G	H	I	J	K	L	M
1													
2	6			5		4		3		2		1	
3													
4	7			8		9		10		11		12	
5													
6	18			17		16		15		14		13	
7													
8	19			20		21		22		23		24	
9													
10	30			29		28		27		26		25	
11													
12	31			32		33		34		35		36	
13													

I, JAMES H. GRANGER, in a field survey on November, 1999, do hereby state that under requirements of P.A. 74, Michigan P.A. of 1970, the corner points mentioned in lines 1 and 2 above were in conformance with regulations and rules therefore as required in the current manual of survey instructions of the United States Department of the Interior, Bureau of Land Management or by a decree of a Court of Law and for that the corner points mentioned in lines 3, 4 and 5 above were in conformance with the rules of the Michigan Board of Land Surveyors or by a Decree of a Court of Law; established, re-established, monumented, recovered, found as expressed below:

NOTE: Not more than 2 corners, all in the same town and range, may be recorded on this certificate.

A. Description of original monument and accessories and/or subsequent restoration:

1837 GLO Lewis Clawson	Set Wood Post 8" Spruce 5" B. Ash	S38°W 22lks N55°W 25lks
---------------------------	---	----------------------------

SURVEY &
REM **MONUMENTATION**

APR 27 2000

B. Description of corner evidence found and/or method applied in restoring or reestablishing corner:

Found 1914 survey documents on Mc Mullen Drain showing corner to be on W. side of Drain. Straight line between SE Sec. 36 and NE Sec. 24 falls on E. side. No original evidence found at either location due to Drain constr. With no other documentation available and considering parol evidence of long time property owners, it was concluded that corner position is on W. side of Drain. Measured S. from NE cor. using data from 1914 Drain survey to establish corner position.


SECTION

C. Description of monument for corner and accessories established to perpetuate locating the position of the corner:

5/8" x 30" rebar w/ Remon Cap	East	46.87' nail & tag 16041
13" B. Ash	S60°E	73.64' nail & cap 16041
6" soft Maple	S47°E	58.25' nail & cap 16041
8" B. Ash	S83°W	33.50' nail & cap 16041

ACCEPTED BY THE IOSCO COUNTY
SURVEY PREP GROUP AS THE
OFFICIAL CORNER UNDER P.A.
345 OF 1990 AT A MEETING
HELD ON 10-13-99

James H. Granger

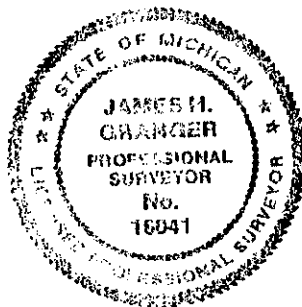

Signed by James H. Granger
Surveyor's Michigan License No. 16041

Date December 15, 1999