

**IOSCO COUNTY REMONUMENTATION
LAND CORNER RECORDATION CERTIFICATE
Filing Requirement of Act 74, Mich. P.A. 1970**

99-55

For corners in

<u> Iosco </u> (County)	Located In:	Corner Code #
1. Public Land Survey	T 21NR 6E	M-12
	T 21NR 7E	A-12
	T ___ R ___	___
	T ___ R ___	___
2. Property Controlling in Section	S ___ T ___ R ___	___
	S ___ T ___ R ___	___
3. Miscellaneous Property in Sec.	S ___ T ___ R ___	___
	S ___ T ___ R ___	___

STATE OF MICHIGAN
IOSCO COUNTY
FILED

20 DEC 99 10:14 A.M.

BOHITA M. COYLE
REGISTER OF DEEDS

Register of Deeds Stamp & File Number

4. Lot No. _____, Recorded Plat _____

5. Private Claims _____

	A	B	C	D	E	F	G	H	I	J	K	L	M
1													
2	6		5		4		3		2		1		
3													
4	7		8		9		10		11		12		
5													
6	18		17		16		15		14		13		
7													
8	19		20		21		22		23		24		
9													
10	30		29		28		27		26		25		
11													
12	31		32		33		34		35		36		
13													

I, JAMES H. GRANGER, in a field survey on December, 1999 do hereby state that under requirements of P.A. 74, Michigan P.A. of 1970, the corner points mentioned in lines 1 and 2 above were in conformance with regulations and rules therefore as required in the current manual of survey instructions of the United States Department of the Interior, Bureau of Land Management or by a decree of a Court of Law and /or that the corner points mentioned in lines 3, 4 and 5 above were in conformance with the rules of the Michigan Board of Land Surveyors or by a Decree of a Court of Law; established, re-established, monumented, recovered, found as expressed below:

NOTE: Not more than 2 corners, all in the same town and range, may be recorded on this certificate.

A. Description of original monument and accessories and/or subsequent restoration:

1837 GLO	Set Wood Post	
Lewis Clawson	12" B. Ash	S60°W 5lks
	9' B. Ash	N33°W 8lks

B. Description of corner evidence found and/or method applied in restoring or reestablishing corner:


Established straight line from NE cor. to SE cor. and calculated location halfway and on-line. Also calculated position on straight line from SE Sec. 36 to NE Sec. 24. No evidence found at either location. Established position at halfway and on-line between NE and SE Sec. corners.

C. Description of monument for corner and accessories established to perpetuate locating the position of the corner:

5/8" x 30" rebar w/ Remon Cap		24.07' nail & tag 16041
8" Soft Maple	N72°E	
8" Soft Maple	East	39.58' nail & cap 16041
4" Ash	S20°E	38.04' nail & cap 16041
7" Ash	N7°E	49.38' nail & cap 16041

ACCEPTED BY THE IOSCO COUNTY
SURVEY PEER GROUP AS THE
OFFICIAL CORNER UNDER P.A.
345 OF 1990 AT A MEETING
HELD ON 10-13-99

James H. Granger

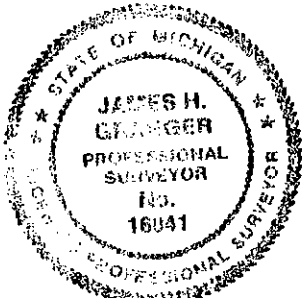

Signed by James H. Granger
Surveyor's Michigan License No. 16041

Date December 15, 1999

100

APR 1 2000

SECTION