

LAND CORNER RECORDATION CERTIFICATE
Filing Requirement of Act 74, Mich. PA 1970

For Corners In:				
<u>Iosco</u>	Located In		Corner Code #	
(County)				
1. Public Land Survey	T	<u>21N</u>	R <u>6E</u>	<u>L-7</u>
	T	<u>21N</u>	R <u>6E</u>	<u>J-6</u>
2. Property Controlling in Section	S	T	R	
	S	T	R	
3. Miscellaneous Property in Section	S	T	R	
	S	T	R	


4. Lot No: _____ Recorded Plat: _____

5. Private Claims: _____

I, Carl T. Kiiskila, in a field survey on November 30, 2000 do hereby state that under requirements of PA 74, Michigan PA of 1970, the corner points mentioned in lines 1 and 2 above were in conformance with regulations and rules therefore as required in the current manual of survey instructions of the United States Department of the Interior, Bureau of Land Management or by a decree of a Court of Law and/or that the corner points mentioned in lines 3, 4 and 5 above were in conformance with the rules of the Michigan Board of Land Surveyors or by a Decree of a Court of Law; established, re-established, monumented, recovered, found as expressed below:

NOTE: Not more than 2 corners, all in the same town and range, may be recorded on this certificate.

Register of Deeds Stamp & File Number

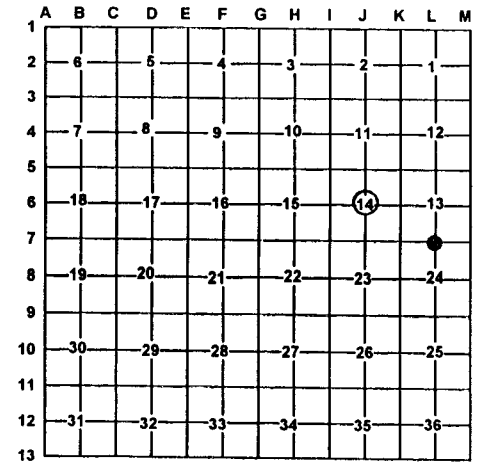

A. Description of original monument and accessories and/or subsequent restoration:

L-7 G.L.O. John Mullett D.S. 1843.
Set quarter section post
Wit: Black Ash 8 N04°E 10 Links
Maple 6 South 6 Links

J-6 This corner position was not established during the original government survey.

B. Description of corner evidence found and/or method applies in restoring or re-establishing corner:

L-7 Found 1/2" rod set by single proportionate measurement by an unknown surveyor.

J-6 Established the center of section 14 at the intersection of the North-South and East-West one-quarter lines.

C. Description of monument for corner and accessories established to perpetuate locating the position of the corner:

L-7 Set 1" X 36" pipe with P.S. cap # 33981 over found 1/2" rod.
Wit: Power Pole N06°W 46.86'
8" Ash S56°W 43.28'
8" Triple Ash S15°E 35.54'
1/2" rod with P.S. cap #41108 South 33.09'
Fence corner post South 35.17'
Centerline of East- West blacktop North 16'±

J-6 Set 5/8" X 32" rerod with P.S. cap #33981
Wit: 10" Red Pine N04°W 5.68'
26" White Pine S77°E 51.52'
6" Twin Red Pine S05°W 7.49'
9" Red Pine S86°W 17.64'

Signed by: Carl T. Kiiskila
Surveyor's Michigan License No.: 33981

Date: 2-06-01

