



LAND CORNER RECORDATION CERTIFICATE
Filing Requirement of Act 74, Mich. PA 1970

For Corners In: losco (County)	Located In	Corner Code #
1. Public Land Survey	T _____ R _____	_____
2. Property Controlling in Section	T _____ R _____	_____
	S 10 T 21N R 6E	2
	S 10 T 21N R 6E	6
3. Miscellaneous Property in Section	S _____ T _____ R _____	_____
	S _____ T _____ R _____	_____
4. Lot No: _____	Recorded Plat: _____	
5. Private Claims: _____		

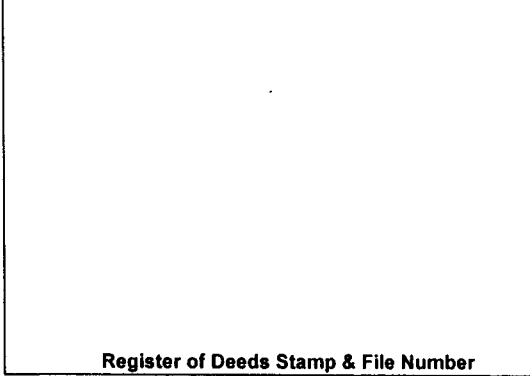

I, Carl T. Kiiskila, in a field survey on November 6, 2000 do hereby state that under requirements of PA 74, Michigan PA of 1970, the corner points mentioned in lines 1 and 2 above were in conformance with regulations and rules therefore as required in the current manual of survey instructions of the United States Department of the Interior, Bureau of Land Management or by a decree of a Court of Law and/or that the corner points mentioned in lines 3, 4 and 5 above were in conformance with the rules of the Michigan Board of Land Surveyors or by a Decree of a Court of Law; established, re-established, monumented, recovered, found as expressed below:

NOTE: Not more than 2 corners, all in the same town and range, may be recorded on this certificate.

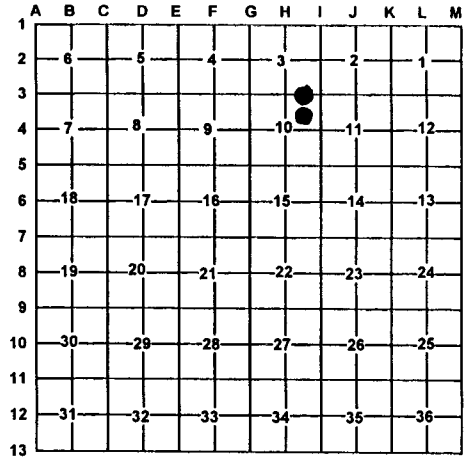

A. Description of original monument and accessories and/or subsequent restoration:

2- This corner position was not established during the original government survey.

6- This corner position was not established during the original government survey.

B. Description of corner evidence found and/or method applies in restoring or re-establishing corner:

2- Established the Northeast of the Northwest quarter of the Northeast quarter of section 10 per B.L.M. instruction for the subdivision of a section.

6- Established the Southwest corner of the Northeast quarter of the Northeast quarter of section 10 per B.L.M. instructions for the subdivision of a section.

C. Description of monument for corner and accessories established to perpetuate locating the position of the corner:

2- Set 5/8" X 32" rered with P.S. cap #33981
 Wit: 14" White Pine S44E° 33.26'
 5" White Pine S10°E 25.42'
 3" White Pine S38°W 38.19'
 Centerline of East-West Blacktop Road North 10.7'
 Carsonite Post South of centerline of road 33'±

6- Set 5/8" X 32" Rerod with P.S. cap #33981
 Wit: 4" Ash N14°W 11.84'
 4" Maple S60°W 17.66'
 4" Cherry N50°W 14.24'
 4" Maple S48°E 32.58'
 Centerline of North-South trail East 46'±
 Carsonite Post North 1'±

Signed by: Carl T. Kiiskila
 Surveyor's Michigan License No.: 33981

Date: 2-06-01

