LAND CORNER RECORDATION CERTIFICATE

Filing Requirement of Act 74, Mich. PA 1970

For Corners In:
Iosco
(County)

Located In

Corner Code #

1. Public Land Survey		T	21N	R	6E	G-5
		T		R		
2. Property Controlling in Section	S 15	T	21N	R	6E	3
	S	T		R		
3. Miscellaneous Property in Section	S	T		R		
	S	T		R		

Register of Deeds Stamp & File Number

4. Lot No: _____ Recorded Plat: _____

5. Private Claims: _____

I, Carl T. Kiiskila, in a field survey on July 18, 2000 do hereby state that under requirements of PA 74, Michigan PA of 1970, the corner points mentioned in lines 1 and 2 above were in conformance with regulations and rules therefore as required in the current manual of survey instructions of the United States Department of the Interior, Bureau of Land Management or by a decree of a Court of Law and/or that the corner points mentioned in lines 3, 4 and 5 above were in conformance with the rules of the Michigan Board of Land Surveyors or by a Decree of a Court of Law; established, re-established, monumented, recovered, found as expressed below:

NOTE: Not more than 2 corners, all in the same town and range, may be recorded on this certificate.

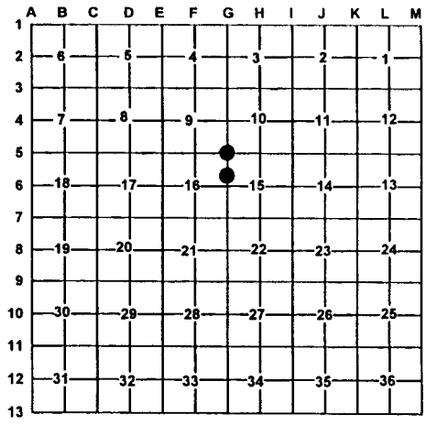

A. Description of original monument and accessories and/or subsequent restoration:

G-5 G.L.O. John Mullet D.S. 1843
White Pine 16 corner to sections 9,10,15, and 16.
Wit: None Given

3- This corner position was not established during the original government survey.

B. Description of corner evidence found and/or method applies in restoring or re-establishing corner:

G-5 Found ½" rerod with P.S. cap #31511

3- Established the Southwest corner of the Northwest quarter of the Northwest quarter of section 15 as per B.L.M. instructions for the subdivision of a section.

C. Description of monument for corner and accessories established to perpetuate locating the position of the corner:

G-5 Found ½" capped rerod P.S.#31511

Wit:			
	*4" Ash	N09°W	23.62'
	*6" Maple	N62°E	41.65'
	*8" Balsam	S42°E	26.41'
	*16" White Pine	N50°W	17.24'
	Center of N-S Road West		110±
	Carsonite post North		1±'

3- Set 5/8"X32" rerod with P.S. cap #33981

Wit:			
	4" Elm	N53°W	47.21'
	7" White Birch	N10°E	5.98'
	5" Elm	S84°E	19.57'
	8" Elm	S78°W	45.78'
	Center of N-S Road West		19±'
	Carsonite post North		1±'

* Old witness by others

Signed by: Carl T. Kiiskila

Date: 2-06-01

Surveyor's Michigan License No.: 33981

STATE OF MICHIGAN
CARL KIISKILA
LAND SURVEYOR
No. 33981
LICENSED LAND SURVEYOR

FORM APPROVED BY MICHIGAN STATE BOARD OF PROFESSIONAL SURVEYORS JAN. 28, 1971
Revised May 14, 1975
Revised Jan. 1983
Revised Oct. 1995