

FEB 16 1999

SECTION

IOSCO COUNTY REMONUMENTATION CORNER  
LAND CORNER RECORDATION CERTIFICATE  
Filing Requirement of Act 74, Mich. P.A. 1970

98-46

STATE OF MICHIGAN  
IOSCO COUNTY  
FILED

8 DEC 98 1:16 P.M.

BONITA M. COYLE  
REGISTER OF DEEDS

For corners in

Iosco  
(County)

Located In:

Corner Code #

1. Public Land Survey

T22N R 5E J-1

T      R     

T      R     

T      R     

2. Property Controlling in Section

S      T      R     

S      T      R     

3. Miscellaneous Property in Sec.

S      T      R     

S      T      R     

Register of Deeds Stamp & File Number

4. Lot No.           , Recorded Plat             
5. Private Claims           

1	A	B	C	D	E	F	G	H	I	J	K	L	M
2		6		5		4		3		2		1	
3													
4		7		8		9		10		11		12	
5													
6		18		17		16		15		14		13	
7													
8		19		20		21		22		23		24	
9													
10		30		29		28		27		26		25	
11													
12		31		32		33		34		35		36	
13													

I, William J. Rigg, in a field survey on Oct. 1, 1998 do hereby state that under requirements of P.A. 74, Michigan P.A. of 1970, the corner points mentioned in lines 1 and 2 above were in conformance with regulations and rules therefore as required in the current manual of survey instructions of the United States Department of the Interior, Bureau of Land Management or by a decree of a Court of Law and/or that the corner points mentioned in lines 3, 4 and 5 above were in conformance with the rules of the Michigan Board of Land Surveyors or by a Decree of a Court of Law; established, re-established, monumented, recovered, found as expressed below:

NOTE: Not more than 2 corners, all in the same town and range, may be recorded on this certificate.

A. Description of original monument and accessories and/or subsequent restoration:

Corner not established in original GLO Survey.

1974 LCRC by James G. Cambell #15397  
Referenced corner as being found and accepted Liber 74, page 293

1991 LCRC by Keyno J. Shellenbarger #30101  
Established corner by proportionate measure using standard and closing corners.


B. Description of corner evidence found and/or method applied in restoring or reestablishing corner:

1994 Survey by Keyno J. Shellenbarger #30101  
References corner Liber 468, Pages 472-474

Found corner as refernced by Keyno J. Shellenbarger

ACCEPTED BY THE IOSCO COUNTY  
SURVEY PEER GROUP AS THE  
OFFICIAL CORNER UNDER P.A.  
885 OF 1989 AT A MEETING  
HELD ON 9-22-98

James H. Shellenbarger

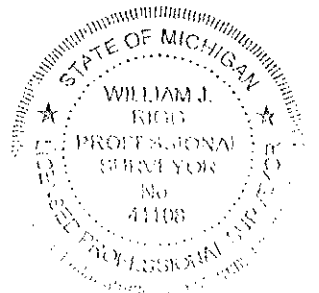

C. Description of monument for corner and accessories established to perpetuate locating the position of the corner:

1998 Remonumentation by William J. Rigg #41108

Fnd. 1/2" Rebar and replaced with a 5/8" Rebar with Remon Cap.

N40W 95.67' SE Cor. Hse. #6844  
S70E 188.02' Power Pole  
West 126.58' Standard S1/4 Sec. 35  
S70W 140.02' Power Pole

Signed by William J. Rigg P.S.  
Surveyor's Michigan License No. #41108

Date Nov. 10, 1998