

**SURVEY &
REMONUMENTATION**

FEB 16 1999

98-38

SECTION

**IOSCO COUNTY REMONUMENTATION CORNER
LAND CORNER RECORDATION CERTIFICATE
Filing Requirement of Act 74, Mich. P.A. 1970**

STATE OF MICHIGAN
IOSCO COUNTY
FILED

For corners in

Iosco
(County)

Located In:

Corner Code #

- 1. Public Land Survey T 22 R 5E K-1
- T R
- T R
- T R
- 2. Property Controlling S T R
- in Section S T R
- 3. Miscellaneous S T R
- Property in Sec. S T R

8 DEC 98 1:15 P.M.

RONITA M. COYLE
REGISTER OF DEEDS

Register of Deeds Stamp & File Number

- 4. Lot No. _____, Recorded Plat _____
- 5. Private Claims _____

William J. Rigg, in a field survey on Oct. 1, 1998 do hereby state that under requirements of P.A. 74, Michigan P.A. of 1970, the corner points mentioned in lines 1 and 2 above were in conformance with regulations and rules therefore as required in the current manual of survey instructions of the United States Department of the Interior, Bureau of Land Management or by a decree of a Court of Law and /or that the corner points mentioned in lines 3, 4 and 5 above were in conformance with the rules of the Michigan Board of Land Surveyors or by a Decree of a Court of Law; established, re-established, monumented, recovered, found as expressed below:

NOTE: Not more than 2 corners, all in the same town and range, may be recorded on this certificate.

1	A	B	C	D	E	F	G	H	I	J	K	L	M
2		6		5		4		3		2		1	
3													
4		7		8		9		10		11		12	
5													
6		18		17		16		15		14		13	
7													
8		19		20		21		22		23		24	
9													
10		30		29		28		27		26		25	
11													
12		31		32		33		34		35		36	
13													

A. Description of original monument and accessories and/or subsequent restoration:

1844 GLO Survey
28" W. Pine S52E 37 lks
30" W. Pine S40W 57 lks

1974 1/2" pipe per LCRC & Survey by James G. Campbell

1991 1/2" rebar per LCRC & Survey by Keyno J. Shellenbarger

B. Description of corner evidence found and/or method applied in restoring or reestablishing corner:

Found and held 1/2" rebar as shown on LCRC 91-9 and referenced to in LCRC 91-8 done by Keyno J. Shellenbarger, #30101.

ACCEPTED BY THE IOSCO COUNTY
SURVEY PEER GROUP AS THE
OFFICIAL CORNER UNDER P.A.
345 OF 1990 AT A MEETING
HELD ON 9-22-98


James H. Shellenbarger

C. Description of monument for corner and accessories established to perpetuate locating the position of the corner:

1998 Remonumentation by William J. Rigg #41108

Fnd. 1/2" Rebar and Replaced with a 5/8" Rebar with Remon Cap.

West 49.50' Standard SE cor. Sec. 35
N40E 170.28' Power Pole
S40E 59.20' Bolt in NW leg of Tower
S60E 105.55' Power Pole

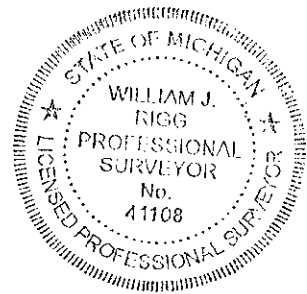

Signed by William J. Rigg P.S.
Surveyor's Michigan License No. #41108

Date Nov 10, 1998