

FEB 16 1999

98-44

SECTION

IOSCO REMONUMENTATION CORNER
LAND CORNER RECORDATION CERTIFICATE
Filing Requirement of Act 74, Mich. P.A. 1970

STATE OF MICHIGAN
IOSCO COUNTY
FILED

8 DEC 98 1:16 P.M.

BONITA K. COYLE
REGISTER OF DEEDS

For corners in

| | | |
|------------------------------------|-------------------|---------------|
| <u>Tosco</u> (County) | Located In: | Corner Code # |
| 1. Public Land Survey | T22NR 5E | K-7 |
| | T ___ R ___ | _____ |
| | T ___ R ___ | _____ |
| | T ___ R ___ | _____ |
| 2. Property Controlling in Section | S ___ T ___ R ___ | _____ |
| | S ___ T ___ R ___ | _____ |
| 3. Miscellaneous Property in Sec. | S ___ T ___ R ___ | _____ |
| | S ___ T ___ R ___ | _____ |

Register of Deeds Stamp & File Number

4. Lot No. _____, Recorded Plat _____
5. Private Claims _____

I, William J. Rigg, in a field survey on Oct. 1, 1998 do hereby state that under requirements of P.A. 74, Michigan P.A. of 1970, the corner points mentioned in lines 1 and 2 above were in conformance with regulations and rules therefore as required in the current manual of survey instructions of the United States Department of the Interior, Bureau of Land Management or by a decree of a Court of Law and/or that the corner points mentioned in lines 3, 4 and 5 above were in conformance with the rules of the Michigan Board of Land Surveyors or by a Decree of a Court of Law; established, re-established, monumented, recovered, found as expressed below:

NOTE: Not more than 2 corners, all in the same town and range, may be recorded on this certificate.

| | | | | | | | | | | | | | |
|----|---|----|---|----|---|----|---|----|---|----|---|----|---|
| 1 | A | B | C | D | E | F | G | H | I | J | K | L | M |
| 2 | | 6 | | 5 | | 4 | | 3 | | 2 | | 1 | |
| 3 | | | | | | | | | | | | | |
| 4 | | 7 | | 8 | | 9 | | 10 | | 11 | | 12 | |
| 5 | | | | | | | | | | | | | |
| 6 | | 18 | | 17 | | 16 | | 15 | | 14 | | 13 | |
| 7 | | | | | | | | | | | | | |
| 8 | | 19 | | 20 | | 21 | | 22 | | 23 | | 24 | |
| 9 | | | | | | | | | | | | | |
| 10 | | 30 | | 29 | | 28 | | 27 | | 26 | | 25 | |
| 11 | | | | | | | | | | | | | |
| 12 | | 31 | | 32 | | 33 | | 34 | | 35 | | 36 | |
| 13 | | | | | | | | | | | | | |

A. Description of original monument and accessories and/or subsequent restoration:

1844+/- GLO SURVEY
Yellow pine for corner
No witnesses given

1974 Survey references corner by Richard Miller, L. 233, P. 867


1997 3/4" Rebar per survey by Herbert J. Kobs

B. Description of corner evidence found and/or method applied in restoring or reestablishing corner:

Found and held 3/4" rebar as shown on survey in 1997 done by Herbert J. Kobs, #14097 and recorded in Liber 530, Page 82.

ACCEPTED BY THE IOSCO COUNTY
SURVEY PEER GROUP AS THE
OFFICIAL CORNER UNDER P.A.
845 OF 1990 AT A MEETING
HELD ON 9-22-98

James H. Krueger

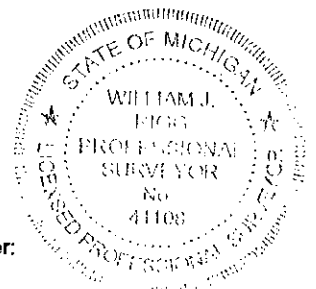

C. Description of monument for corner and accessories established to perpetuate locating the position of the corner:

1998 Remonumentation by William J. Rigg, #41108

Found 3/4" Rebar and replaced with 5/8" Rebar with Remon Cap.

- N45W 83.93' Power Pole
- N40E 78.14' Fence Post
- S40E 78.44' Power Pole
- S40W 196.42' Power Pole

Signed by William J. Rigg P.S.
Surveyor's Michigan License No. #41108

Date Nov. 10, 1998