

FEB 16 1999

SECTION

IOSCO COUNTY REMONUMENTATION CORNER  
LAND CORNER RECORDATION CERTIFICATE  
Filing Requirement of Act 74, Mich. P.A. 1970

STATE OF MICHIGAN  
IOSCO COUNTY  
FILED

8 DEC 98 1:15 P.M.

BONITA M. DOYLE  
REGISTER OF DEEDS

98-41

Register of Deeds Stamp & File Number

For corners in

<u>Iosco</u> (County)	Located In:	Corner Code #
1. Public Land Survey	T22NR5E	L-1
	T___R___	_____
	T___R___	_____
	T___R___	_____
2. Property Controlling in Section	S___T___R___	_____
	S___T___R___	_____
3. Miscellaneous Property in Sec.	S___T___R___	_____
	S___T___R___	_____

4. Lot No. \_\_\_\_\_, Recorded Plat \_\_\_\_\_  
5. Private Claims \_\_\_\_\_

I, William J. Rigg in a field survey on Oct. 1, 1998 do hereby state that under requirements of P.A. 74, Michigan P.A. of 1970, the corner points mentioned in lines 1 and 2 above were in conformance with regulations and rules therefore as required in the current manual of survey instructions of the United States Department of the Interior, Bureau of Land Management or by a decree of a Court of Law and/or that the corner points mentioned in lines 3, 4 and 5 above were in conformance with the rules of the Michigan Board of Land Surveyors or by a Decree of a Court of Law; established, re-established, monumented, recovered, found as expressed below:

NOTE: Not more than 2 corners, all in the same town and range, may be recorded on this certificate.

	A	B	C	D	E	F	G	H	I	J	K	L	M
1													
2	6		5		4		3		2		1		
3													
4	7		8		9		10		11		12		
5													
6	10		17		16		15		14		13		
7													
8	19		20		21		22		23		24		
9													
10	30		29		28		27		26		25		
11													
12	31		32		33		34		35		36		
13													

A. Description of original monument and accessories and/or subsequent restoration:


Corner not set in original GLO Survey

Re-established corner position on line between standard corners K-13 and M-13, T23N, R5E at proportionate distance between K-1 and M-1, of T22N, R5E. Re-established position falls 0.9 feet West of 1" by 1" wood post found leaning to the East, 1' below the road bed. Position also agrees with fence line to the South.

B. Description of corner evidence found and/or method applied in restoring or reestablishing corner:

ACCEPTED BY THE IOSCO COUNTY  
SURVEY PEER GROUP AS THE  
OFFICIAL CORNER UNDER P.A.  
245 OF 1990 AT A MEETING  
HELD ON 9-22-98

*James H. Granger*

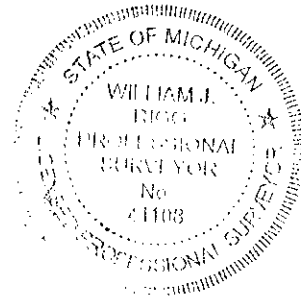

C. Description of monument for corner and accessories established to perpetuate locating the position of the corner:

1998 Remonumentation by William J. Rigg #41108

Nothing Fnd. Reestablished corner position on line and between standard corners.

Set 5/8" rebar with Remonumentation Cap #41108

- S05E 31.55' Power Pole
- N35E 189.27' Power Pole
- S10W 79.68' 14" Twin Ash
- N25W 48.85' 18" Twin Ash

Signed by William J. Rigg  
Surveyor's Michigan License No. #41108

Date Nov 10, 1998