

FEB 16 1999

SECTION

IOSCO COUNTY REMONUMENTATION CORNER
LAND CORNER RECORDATION CERTIFICATE
Filing Requirement of Act 74, Mich. P.A. 1970

98-39

STATE OF MICHIGAN
IOSCO COUNTY
FILED

8 DEC 98 1:15 P.M.

BONITA M. COYLE
REGISTER OF DEEDS

For corners in

Iosco (County)	Located In:	Corner Code #
1. Public Land Survey	T22N R5E	L-5
	T R	
	T R	
	T R	
2. Property Controlling in Section	S T R	
	S T R	
3. Miscellaneous Property in Sec.	S T R	
	S T R	

Register of Deeds Stamp & File Number

4. Lot No. _____, Recorded Plat _____
5. Private Claims _____

I, William J. Rigg in a field survey on Oct. 1, 1998 do hereby state that under requirements of P.A. 74, Michigan P.A. of 1970, the corner points mentioned in lines 1 and 2 above were in conformance with regulations and rules therefore as required in the current manual of survey instructions of the United States Department of the Interior, Bureau of Land Management or by a decree of a Court of Law and/or that the corner points mentioned in lines 3, 4 and 5 above were in conformance with the rules of the Michigan Board of Land Surveyors or by a Decree of a Court of Law; established, re-established, monumented, recovered, found as expressed below:

NOTE: Not more than 2 corners, all in the same town and range, may be recorded on this certificate.

1	A	B	C	D	E	F	G	H	I	J	K	L	M
2		6		5		4		3		2		1	
3													
4		7		8		9		10		11		12	
5													
6		18		17		16		15		14		13	
7													
8		19		20		21		22		23		24	
9													
10		30		29		28		27		26		25	
11													
12		31		32		33		34		35		36	
13													

A. Description of original monument and accessories and/or subsequent restoration:

1838+/- GLO SURVEY
24" B. Oak N64E 22 lks.
12" Maple S27E 40 lks.

B. Description of corner evidence found and/or method applied in restoring or reestablishing corner:

Found no evidence of corner. Fence corner position falls 14' South and 4' East of calculated proportionate distance between K-5 and M-5. Re-established position at fence corner position.

ACCEPTED BY THE IOSCO COUNTY
SURVEY PEER GROUP AS THE
OFFICIAL CORNER UNDER P.A.
345 OF 1990 AT A MEETING
HELD ON 9-22-98


James H. Granger

C. Description of monument for corner and accessories established to perpetuate locating the position of the corner:

1998 Remonumentation by William J. Rigg, #41108

Nothing found. Set 5/8" Rebar with Remon Cap.

S85W 205.67' Quad Elm
S40E 35.84' 30" Elm
N45E 162.87' Maple Clump (4')
N30E 103.07' 20" Maple

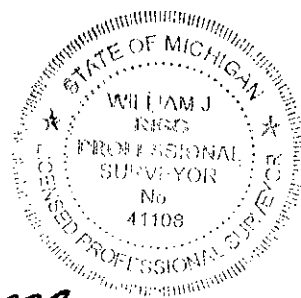

Signed by William J. Rigg, P.E.
Surveyor's Michigan License No. #41108

Date Nov 10, 1998