

FEB 16 1999

98-49

STATE OF MICHIGAN  
IOSCO COUNTY  
FILED

IOSCO COUNTY REMONUMENTATION CORNER  
LAND CORNER RECORDATION CERTIFICATE  
Filing Requirement of Act 74, Mich. P.A. 1970

8 DEC 98 1:20 P.M.

RONITA M. CYRLE  
REGISTER OF DEEDS

For corners in

Iosco

(County)

Located In:

Corner Code #

1. Public Land Survey

T 22 R 5 E M-3  
T 22 NR 6 E A-3

2. Property Controlling in Section

S T R

3. Miscellaneous Property in Sec.

S T R  
S T R

Register of Deeds Stamp & File Number

4. Lot No. , Recorded Plat

5. Private Claims

William J. Rigg, in a field survey on Oct. 1, 1998 do hereby state that under requirements of P.A. 74, Michigan P.A. of 1970, the corner points mentioned in lines 1 and 2 above were in conformance with regulations and rules therefore as required in the current manual of survey instructions of the United States Department of the Interior, Bureau of Land Management or by a decree of a Court of Law and/or that the corner points mentioned in lines 3, 4 and 5 above were in conformance with the rules of the Michigan Board of Land Surveyors or by a Decree of a Court of Law; established, re-established, monumented, recovered, found as expressed below:

NOTE: Not more than 2 corners, all in the same town and range, may be recorded on this certificate.

1	A	B	C	D	E	F	G	H	I	J	K	L	M
2		6		5		4		3		2		1	
3													
4		7		8		9		10		11		12	
5													
6		18		17		16		15		14		13	
7													
8		19		20		21		22		23		24	
9													
10		30		29		28		27		26		25	
11													
12		31		32		33		34		35		36	
13													

A. Description of original monument and accessories and/or subsequent restoration:

1844 GLO Survey  
14" Y. Pine S46W 26 lks  
12" W. Pine N45W 14 lks

1974 LCRC references corner by James G. Campbell

1940 GLO RE-SURVEY  
6" W. Birch N56.5E 12 lks  
5" Maple S54E 73 lks  
6" Poplar N56W 75 lks

1992 Raised 1/2" pipe with 1/2" rebar by Keyno J. Shellenbarger


1995 Found 1/2" pipe per survey by Herbert J. Kobs

B. Description of corner evidence found and/or method applied in restoring or reestablishing corner:

Fnd. pipe with raised bar and cap as recorded by Herbert J. Kobs, #14097, as recorded in 1995, Liber 514, Page 47.

ACCEPTED BY THE IOSCO COUNTY  
SURVEY PEER GROUP AS THE  
OFFICIAL CORNER UNDER P.A.  
74 OF 1970 AT A MEETING  
HELD ON 9-22-98

James A. Krueger

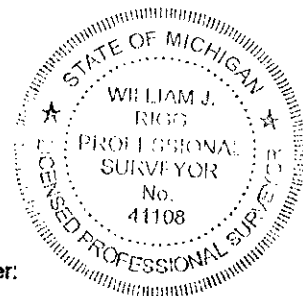

C. Description of monument for corner and accessories established to perpetuate locating the position of the corner:

1998 Remonumentation by William J. Rigg #41108

Fnd. Pipe and raised bar w/cap and replaced with 5/8" rebar and Remon Cap.

S54E 46.92' 20" Blazed Maple  
N80W 59.58' White Pine  
N30E 44.84' 24" Maple  
S40W 110.18' 12" White Pine

Signed by William J. Rigg P.S.  
Surveyor's Michigan License No. #41108

Date Nov. 10, 1998