

SURVEY & REMONUMENTATION

DEC 13 1993

COMMISSION

FILED 93-27

IOSCO COUNTY REMONUMENTATION CORNER LAND CORNER RECORDATION CERTIFICATE

DEC 1 11 05 AM '93

Filing Requirement of Act 74, Mich. P.A. 1970

Bonita M. Coyle

REGISTER OF DEEDS IOSCO COUNTY, MICH.

Form with fields for Iosco (County), Located In, Corner Code #, and numbered sections 1-5 for survey details.

Register of Deeds Stamp & File Number

Grid table with columns A-M and rows 2-13, containing numbers 1-36.

I, James H. Granger, in a field survey on November 15-17, 1993, do hereby certify that under requirements of P.A. 74, Michigan P.A. of 1970, the corner points mentioned in lines 1 and 2 above were in conformance with regulations and rules therefore as required in the current manual of survey instructions of the United States Department of the Interior, Bureau of Land Management or by a decree of a Court of Law and/or that the corner points mentioned in lines 3, 4 and 5 above were in conformance with the rules of the Michigan Board of Land Surveyors or by a Decree of a Court of Law; established, re-established, monumented, re-monumented, recovered, found as expressed below:

NOTE: Not more than 4 corners, all in the same town and range, may be recorded on this certificate.

A. Description of original monument and accessories and/or subsequent restoration:

1938 Original Survey, Lewis Clason
Set Wood Post
10" Hemlock S37°W 32 lks.
10" White Pine N42°W 30 Lks.

1931 Dependent Resurvey, Guy Veal


B. Description of corner evidence found and/or method applied in restoring or reestablishing corner:

Fd. 3/4" pipe at intersection of E-W fences and gravel road
Fd. one 1931 BT - distance checks position within 2"

Position accepted as most probable location of mounument set in 1931 Dependent Resurvey

C. Description of monument for corner and accessories established to perpetuate locating the position of the corner:

5/8" by 30" rod with 3" dia. alumin cap
Fd. 32" white oak N50°E± 121.0' (120.12'R)
Set Nail and Tag PS #16041 in:
14" Twin Oak N78°E 30.38'
6" Oak N35°E 77.03'
12" Oak N50°W 46.26'
5" White Oak West 48.55'

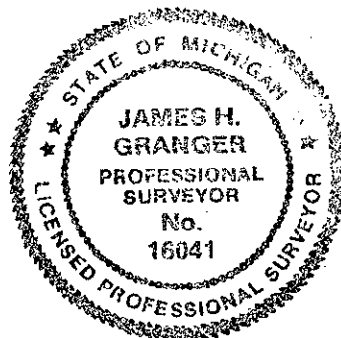

Signed by James H. Granger

Date Nov. 30, 1993

Surveyor's Michigan License No. 16041