

SURVEY & REMONUMENTATION

DEC 13 1993

COMMISSION

IOSCO COUNTY REMONUMENTATION CORNER LAND CORNER RECORDATION CERTIFICATE

Filing Requirement of Act 74, Mich. P.A. 1970

93-31

FILED

DEC 1 11 06 AM '93

REGISTER OF DEEDS
IOSCO COUNTY, MICH.
Charles H. Decker

For corners in

<u>Iosco</u> (County)	Located In:	Corner Code #/
1. Public Land Survey	T <u>22N</u> R <u>6E</u>	<u>B-7</u>
	T _____ R _____	_____
	T _____ R _____	_____
	T _____ R _____	_____
2. Property Controlling in Section	S _____ T _____ R _____	_____
	S _____ T _____ R _____	_____
3. Miscellaneous Property in Sec.	S _____ T _____ R _____	_____
	S _____ T _____ R _____	_____

Register of Deeds Stamp & File Number

4. Lot No. _____, Recorded Plat _____
5. Private Claims _____

I, James H. Granger, in a field survey on November 15-17, 1993, do hereby certify that under requirements of P.A. 74, Michigan P.A. of 1970, the corner points mentioned in lines 1 and 2 above were in conformance with regulations and rules therefore as required in the current manual of survey instructions of the United States Department of the Interior, Bureau of Land Management or by a decree of a Court of Law and/or that the corner points mentioned in lines 3, 4 and 5 above were in conformance with the rules of the Michigan Board of Land Surveyors or by a Decree of a Court of Law; established, re-established, monumented, re-monumented, recovered, found as expressed below:

NOTE: Not more than 4 corners, all in the same town and range, may be recorded on this certificate.

	A	B	C	D	E	F	G	H	I	J	K	L	M
2	6	5	4	3	2	1							
3													
4	7	8	9	10	11	12							
5													
6	18	17	16	15	14	13							
7	●												
8	19	20	21	22	23	24							
9													
10	30	29	28	27	26	25							
11													
12	31	32	33	34	35	36							
13													

A. Description of original monument and accessories and/or subsequent restoration:

1843 Original Survey, John Mullett
Set Wood Post
6" Cedar S59°E 8 lks
8" Tamarack N33°W 6lks

1931 Dependent Resurvey, Guy Veal
1985 Tim Lapham #27595


B. Description of corner evidence found and/or method applied in restoring or reestablishing corner:

Fd. 1/2" rorod with Cap #27595 at intersection of fences
Fd. 2 witness set in 1985

Position accepted as most probable location of monument set in 1931 Dependent Resurvey.

C. Description of monument for corner and accessories established to perpetuate locating the position of the corner:

5/8" by 30" rod with 3" dia. alumin. cap
Fd. Witnesses: Fence Post North 9.92'
5" Cedar S80°E 8.92'
Set nail & Tag PS#16041 in:
18" White Pine S75°W 48.03'
8" Fir N25°E 26.15'

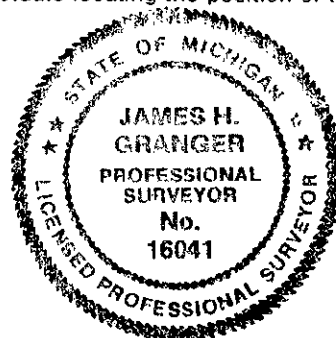

Signed by James H. Granger
Surveyor's Michigan License No. 16041

Date Nov. 30, 1993