

**SURVEY & REMONUMENTATION**

DEC 13 1993

COMMISSION

**IOSCO COUNTY REMONUMENTATION CORNER  
LAND CORNER RECORDATION CERTIFICATE**  
Filing Requirement of Act 74, Mich. P.A. 1970

For corners in

<u>Iosco</u> <small>(County)</small>	Located In:	Corner Code #:
1. Public Land Survey	T <u>22N</u> R <u>6E</u>	<u>C-6</u>
	T _____ R _____	_____
	T _____ R _____	_____
	T _____ R _____	_____
2. Property Controlling in Section	S _____ T _____ R _____	_____
	S _____ T _____ R _____	_____
3. Miscellaneous Property in Sec.	S _____ T _____ R _____	_____
	S _____ T _____ R _____	_____
4. Lot No. _____, Recorded Plat _____		
5. Private Claims _____		

REGISTER OF DEEDS  
IOSCO COUNTY, MICH.

*Barbara M. Coyle*

DEC 11 11 06 AM '93

FILED

93-33

Register of Deeds Stamp & File Number

I, **James H. Granger**, in a field survey on November 15-17, 19 93, do hereby certify that under requirements of P.A. 74, Michigan P.A. of 1970, the corner points mentioned in lines 1 and 2 above were in conformance with regulations and rules therefore as required in the current manual of survey instructions of the United States Department of the Interior, Bureau of Land Management or by a decree of a Court of Law and/or that the corner points mentioned in lines 3, 4 and 5 above were in conformance with the rules of the Michigan Board of Land Surveyors or by a Decree of a Court of Law; established, re-established, monumented, re-monumented, recovered, found as expressed below:

**NOTE: Not more than 4 corners, all in the same town and range, may be recorded on this certificate.**

	A	B	C	D	E	F	G	H	I	J	K	L	M
2	6		5		4		3		2		1		
3													
4	7		8		9		10		11		12		
5													
6	18		17		16		15		14		13		
7													
8	19		20		21		22		23		24		
9													
10	30		29		28		27		26		25		
11													
12	31		32		33		34		35		36		
13													

A. Description of original monument and accessories and/or subsequent restoration:


**1843 Original Survey, John Mullett**  
Set Wood Post  
6" Cedar S59°E 8 lks  
8" Tamarack N33°W 6 lks  
1931 Dependent Resurvey, Guy Veal

B. Description of corner evidence found and/or method applied in restoring or reestablishing corner:

**Fd. 3 1/4" dia. brass cap on conc. cylinder**  
**No evidence of witnesses**

C. Description of monument for corner and accessories established to perpetuate locating the position of the corner:

**Left 3 1/4" dia brass cap on conc. cylinder**  
**Set nail & tag PS #16041 in:**  
8" Cedar S87°W 17.38'  
10" Cedar S85°E 31.46'  
6" Cedar S17°E 21.25'  
6" Cedar N07°E 20.24'

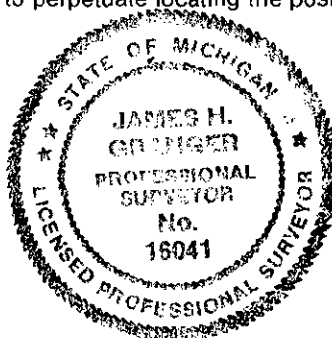

Signed by James H. Granger Date Nov. 30, 1993  
Surveyor's Michigan License No. 16041