

**SURVEY & REMONUMENTATION**

DEC 13 1993

COMMISSION

**IOSCO COUNTY REMONUMENTATION CORNER  
LAND CORNER RECORDATION CERTIFICATE**  
Filing Requirement of Act 74, Mich. P.A. 1970

For corners in

<u>IOSCO</u> (County)	Located In:	Corner Code #
1. Public Land Survey	T <u>22N</u> R <u>6E</u>	<u>G-5</u>
	T _____ R _____	_____
	T _____ R _____	_____
	T _____ R _____	_____
2. Property Controlling in Section	S _____ T _____ R _____	_____
	S _____ T _____ R _____	_____
3. Miscellaneous Property in Sec.	S _____ T _____ R _____	_____
	S _____ T _____ R _____	_____
4. Lot No. _____, Recorded Plat _____		
5. Private Claims _____		

REGISTER OF DEEDS  
 IOSCO COUNTY, MICH.  
 Nov 24 4 32 PM '93  
**93-24**  
 FILED

Register of Deeds Stamp & File Number


I, RICHARD L. MILLER in a field survey on OCTOBER 5, 19 93, do hereby certify that under requirements of P.A. 74, Michigan P.A. of 1970, the corner points mentioned in lines 1 and 2 above were in conformance with regulations and rules therefore as required in the current manual of survey instructions of the United States Department of the Interior, Bureau of Land Management or by a decree of a Court of Law and/or that the corner points mentioned in lines 3, 4 and 5 above were in conformance with the rules of the Michigan Board of Land Surveyors or by a Decree of a Court of Law, established, re-established, monumented, re-monumented, recovered, found as expressed below:

A	B	C	D	E	F	G	H	I	J	K	L	M
2	6	5	4	3	2							
3												
4	7	8	9	10	11	12						
5												
6	18	17	16	15	14	13						
7												
8	19	20	21	22	23	24						
9												
10	30	29	28	27	26	25						
11												
12	31	32	33	34	35	36						
13												

**NOTE: Not more than 4 corners, all in the same town and range, may be recorded on this certificate.**

- A. Description of original monument and accessories and/or subsequent restoration:
- 1843 ORIGINAL SUBDIVISION MULLETT & BURT  
SET WOOD POST  
12" SPRUCE S.84 W. 19 LKS  
8" SPRUCE N.69 E. 21 LKS
  - 1931 DEPENDANT RESURVEY GUY VEAL, APPROVED 1933  
SET 3½" BRASS TABLET IN 6" DIAMETER CONCRETE CYLINDER, 24" LONG  
8" B. OAK N.07¼ E. 472 LKS  
7" B. OAK N.42½ W. 259 LKS
  - 1964 U.S.F.S. ROBERT A. GRIFFIN R.L.S. #13584
- B. Description of corner evidence found and/or method applied in restoring or reestablishing corner:
- FOUND 1931 MONUMENT IN ORIGINAL POSITION 4" ABOVE GROUND  
7" (NOW 28") B. OAK N.42½ W. 171.00' (1931)

- C. Description of monument for corner and accessories established to perpetuate locating the position of the corner:
- 3½" DIAMETER BRASS CAP IN 6" CONCRETE CYLINDER, 24" LONG  
SET WITNESS TAG IN S.W. SIDE OF 14" B. OAK N.32 W., 27.82' (1964)  
SET WITNESS TAG IN S. SIDE OF 8" J. PINE N.80 E. 78.72' (1964)  
SET WITNESS TAG IN E. SIDE OF 22" MAPLE S.11 E. 72.65' (1964)  
SET WITNESS TAG IN N.E. SIDE OF 28" B. OAK N.42½ W. 170.74' (1931)

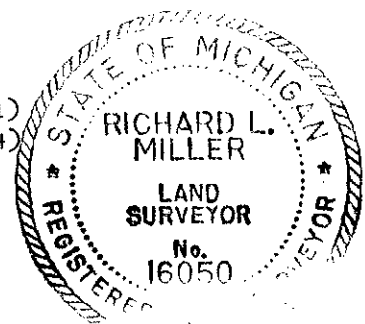

Signed by *Richard L. Miller* Date NOVEMBER 17, 1993  
 Surveyor's Michigan License No. 16050