SURVEY & REMONUMENTATION

DEC 1 3 1993

COMMISSION

IOSCO COUNTY REMONUMENTATION CORNER

LAND CORNER RECORDATION CERTIFICATE

Filing Requirement of Act 74, Mich. P.A. 1970

FILED 93-16 Nov 24 4 32 PM '93

REGISTER OF DEEDS IOSCO COUNTY, MICH.

For corners in IOSCO (County)

	Located In:	Corner Code #
1. Public Land Survey	T 22N R 6E	G-6
	T ____ R ____	
	T ____ R ____	
	T ____ R ____	
2. Property Controlling	S ____ T ____ R ____	
in Section	S ____ T ____ R ____	
3. Miscellaneous	S ____ T ____ R ____	
Property in Sec.	S ____ T ____ R ____	

Register of Deeds Stamp & File Number

4. Lot No. _____ , Recorded Plat _____
5. Private Claims _____

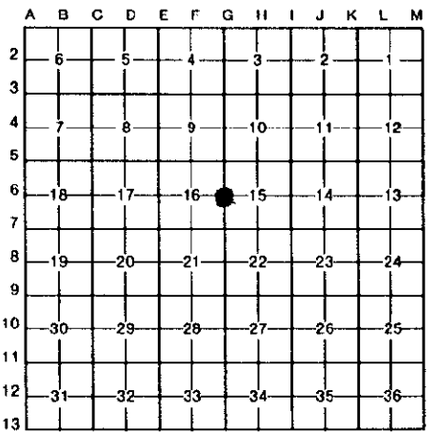

I, RICHARD L. MILLER in a field survey on NOVEMBER 9, 19 93. do hereby certify that under requirements of P.A. 74, Michigan P.A. of 1970, the corner points mentioned in lines 1 and 2 above were in conformance with regulations and rules therefore as required in the current manual of survey instructions of the United States Department of the Interior, Bureau of Land Management or by a decree of a Court of Law and/or that the corner points mentioned in lines 3, 4 and 5 above were in conformance with the rules of the Michigan Board of Land Surveyors or by a Decree of a Court of Law; established, re-established, monumented, re-monumented, recovered, found as expressed below:

NOTE: Not more than 4 corners, all in the same town and range, may be recorded on this certificate.

A. Description of original monument and accessories and/or subsequent restoration:

1843 ORIGINAL SUBDIVISION MULLETT & BURT
SET WOOD POST
14" HEMLOCK N.18 E. 30 LKS
6" B. ASH S.07 W. 18 LKS

1931 DEPENDANT RESURVEY GUY VEAL, APPROVED 1933
SET 3½" BRASS TABLET IN 6" DIAMETER CONCRETE CYLINDER, 24" LONG
4" WHITE BIRCH S.31¼ E. 64½ LKS
4" POPLAR N.18½ W. 84 LKS

B. Description of corner evidence found and/or method applied in restoring or reestablishing corner:

FOUND 1931 MONUMENT IN ORIGINAL POSITION 1.0' BELOW SURFACE IN NORTH-SOUTH ROAD CENTERLINE. OLD FENCE RUNNING WEST, 5' NORTH OF CORNER. 1931 WITNESSES GONE.

C. Description of monument for corner and accessories established to perpetuate locating the position of the corner:

3½" DIAMETER BRASS CAP IN 6" CONCRETE CYLINDER, 24" LONG.
SET 5/8" RE-ROD ON SOUTH EDGE CYLINDER FOR MAGNETIC ATTRACTION
SET WITNESS TAG IN N.W. SIDE OF 12" TWIN MAPLE N.40 E. 95.56'
SET WITNESS TAG IN S.W. SIDE OF 8" W. PINE S.40 E. 87.52'
SET WITNESS TAG IN S.E. SIDE OF 20"-7" DBL MAPLE S.45 W. 75.31'
SET WITNESS TAG IN N.E. SIDE OF 6" W. PINE N.20 W. 131.90'

STATE OF MICHIGAN
RICHARD L. MILLER
LAND SURVEYOR
No. 16050
REGISTERED LAND SURVEYOR

Signed by Richard L. Miller Date NOVEMBER 17, 1993

Surveyor's Michigan License No. 16050

FORM APPROVED BY MICHIGAN STATE BOARD OF LAND SURVEYORS, JAN. 28, 1971
REVISED MAY 14, 1975
REVISED JAN., 1983

IOSCO COUNTY REMONUMENTATION CORNER