

SURVEY & REMONUMENTATION

DEC 13 1993

COMMISSION

**IOSCO COUNTY REMONUMENTATION CORNER
LAND CORNER RECORDATION CERTIFICATE
Filing Requirement of Act 74, Mich. P.A. 1970**

For corners in


IOSCO (County)	Located In:	Corner Code #
1. Public Land Survey	T 22N R 6E	G-7
	T _____ R _____	_____
	T _____ R _____	_____
	T _____ R _____	_____
2. Property Controlling in Section	S _____ T _____ R _____	_____
	S _____ T _____ R _____	_____
3. Miscellaneous Property in Sec.	S _____ T _____ R _____	_____
	S _____ T _____ R _____	_____

REGISTER OF DEEDS
IOSCO COUNTY, MICH.

93-23
FILED
NOV 24 4 32 PM '93

Register of Deeds Stamp & File Number

4. Lot No. _____, Recorded Plat _____
5. Private Claims _____

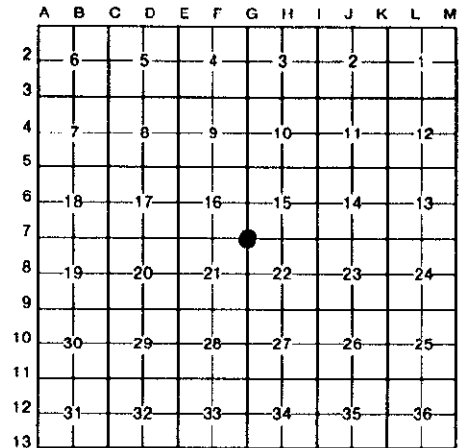

I, RICHARD L. MILLER in a field survey on OCTOBER 5, 19 93, do hereby certify that under requirements of P.A. 74, Michigan P.A. of 1970, the corner points mentioned in lines 1 and 2 above were in conformance with regulations and rules therefore as required in the current manual of survey instructions of the United States Department of the Interior, Bureau of Land Management or by a decree of a Court of Law and/or that the corner points mentioned in lines 3, 4 and 5 above were in conformance with the rules of the Michigan Board of Land Surveyors or by a Decree of a Court of Law; established, re-established, monumented, re-monumented, recovered, found as expressed below:

NOTE: Not more than 4 corners, all in the same town and range, may be recorded on this certificate.

A. Description of original monument and accessories and/or subsequent restoration:

- 1843 ORIGINAL SUBDIVISION MULLETT & BURT
SET WOOD POST
16" HEMLOCK S.25 E. 38 LKS
12" HEMLOCK N.59 W. 5 LKS
- 1931 DEPENDANT RESURVEY GUY VEAL, APPROVED 1933
SET 3½" BRASS TABLET IN 6" DIAMETER CONCRETE CYLINDER, 24" LONG
8" ELM S.10 E. 347 LKS
5" ELM S.49¼ W. 120 LKS
- 1964 U.S.F.S. ROBERT A. GRIFFIN R.L.S. #13584

B. Description of corner evidence found and/or method applied in restoring or reestablishing corner:

- FOUND CONCRETE CYLINDER DAMAGED WITH BRASS CAP REMOVED. IN ROAD CENTERLINE INTERSECTION NORTH-SOUTH AND WEST. 1964 WITNESSES FOUND
- 10" DOCK SPIKE IN S.E. SIDE 6" MAPLE S.19 W. 104.70'
- 10" DOCK SPIKE IN N.W. SIDE 7" W. PINE S.74 W. 140.95'

C. Description of monument for corner and accessories established to perpetuate locating the position of the corner:

- SET MONUMENT CONSISTING OF 3" ALUMINUM DISC ATTACHED TO 5/8" RE-ROD, 30" LONG, PLACED 6" BELOW SURFACE. MARKED T.22N.-R.6E. 15-16-21-22
- SET WITNESS TAG IN N.W. SIDE POWER POLE N.46 E. 77.45'
- SET WITNESS TAG IN N.E. SIDE 8" ASH N.25 W. 68.95'
- SET WITNESS TAG IN S.W. SIDE FENCE CORNER POST N.44 W. 44.97'
- 10" DOCK SPIKE IN S.E. SIDE 10" MAPLE S.19 W. 104.00' (1964)
- 10" DOCK SPIKE IN N.W. SIDE 17" W. PINE N.74 W. 140.95' (1964)

Signed by Richard L. Miller Date NOVEMBER 17, 1993
Surveyor's Michigan License No. 16050

