

**SURVEY & REMONUMENTATION**

DEC 13 1993

COMMISSION

**IOSCO COUNTY REMONUMENTATION CORNER  
LAND CORNER RECORDATION CERTIFICATE  
Filing Requirement of Act 74, Mich. P.A. 1970**

**93-35**  
FILED

DEC 11 06 AM '93

*Boris H. Coyle*  
REGISTER OF DEEDS  
IOSCO COUNTY, MICH.

For corners in

<u>Iosco</u> (County)	Located In:	Corner Code #
1. Public Land Survey	T <u>22N</u> R <u>6E</u>	<u>H-5</u>
	T _____ R _____	_____
	T _____ R _____	_____
	T _____ R _____	_____
2. Property Controlling in Section	S _____ T _____ R _____	_____
	S _____ T _____ R _____	_____
3. Miscellaneous Property in Sec.	S _____ T _____ R _____	_____
	S _____ T _____ R _____	_____

Register of Deeds Stamp & File Number

4. Lot No. \_\_\_\_\_, Recorded Plat \_\_\_\_\_  
5. Private Claims \_\_\_\_\_

	A	B	C	D	E	F	G	H	I	J	K	L	M
2	6		5		4		3		2		1		
3													
4	7		8		9		10		11		12		
5								●					
6	13		17		16		15		14		13		
7													
8	19		20		21		22		23		24		
9													
10	30		29		28		27		26		25		
11													
12	31		32		33		34		35		36		
13													

I, James H. Granger, in a field survey on November 15-17, 19 93, do hereby certify that under requirements of P.A. 74, Michigan P.A. of 1970, the corner points mentioned in lines 1 and 2 above were in conformance with regulations and rules therefore as required in the current manual of survey instructions of the United States Department of the Interior, Bureau of Land Management or by a decree of a Court of Law and/or that the corner points mentioned in lines 3, 4 and 5 above were in conformance with the rules of the Michigan Board of Land Surveyors or by a Decree of a Court of Law; established, re-established, monumented, re-monumented, recovered, found as expressed below:

**NOTE: Not more than 4 corners, all in the same town and range, may be recorded on this certificate.**

A. Description of original monument and accessories and/or subsequent restoration:


- 1843 Original Survey, John Mullett
- Set Wood Post
- 10" Spruce Pine N55°W 71ks
- 10" Spruce Pine S72°E 291ks
- 1931 Dependent Resurvey, Robert Griffin #13584
- 1974 James Campbell #15397

B. Description of corner evidence found and/or method applied in restoring or reestablishing corner:

- Fd. 5 1/4" dia brass cap on conc. cylinder
- Fd. 4 USFS witnesses

C. Description of monument for corner and accessories established to perpetuate locating the position of the corner:

- 3 1/4" dia. brass cap on conc. cylinder
- USFS Tagged Witnesses: 24" Black Oak S63.75°W 42.25"
- 16" Red Pine N80°W 48.00'
- 16" Oak N12°E 35.31'
- 12" Twin Oak N42°E 25.12'

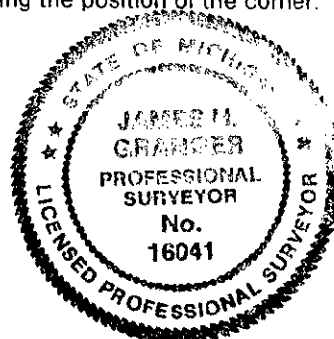

Signed by James H. Granger Date Nov. 30, 1993  
Surveyor's Michigan License No. 16041