

DEC 13 1993

COMMISSION

**IOSCO COUNTY REMONUMENTATION CORNER  
LAND CORNER RECORDATION CERTIFICATE**  
Filing Requirement of Act 74, Mich. P.A. 1970

For corners in

<u>Iosco</u> <small>(County)</small>	Located In:	Corner Code #
1. Public Land Survey	T <u>22N</u> R <u>6E</u>	<u>I-6</u>
	T _____ R _____	_____
	T _____ R _____	_____
	T _____ R _____	_____
2. Property Controlling in Section	S _____ T _____ R _____	_____
	S _____ T _____ R _____	_____
3. Miscellaneous Property in Sec.	S _____ T _____ R _____	_____
	S _____ T _____ R _____	_____
4. Lot No. _____, Recorded Plat _____		
5. Private Claims _____		

REGISTER OF DEEDS  
IOSCO COUNTY, MICH.

*James H. Granger*

DEC 1 11 06 AM '93

FILED

93-38

Register of Deeds Stamp & File Number

I, James H. Granger, in a field survey on November 15-17, 19 93, do hereby certify that under requirements of P.A. 74, Michigan P.A. of 1970, the corner points mentioned in lines 1 and 2 above were in conformance with regulations and rules therefore as required in the current manual of survey instructions of the United States Department of the Interior, Bureau of Land Management or by a decree of a Court of Law and/or that the corner points mentioned in lines 3, 4 and 5 above were in conformance with the rules of the Michigan Board of Land Surveyors or by a Decree of a Court of Law; established, re-established, monumented, re-monumented, recovered, found as expressed below:

**NOTE: Not more than 4 corners, all in the same town and range, may be recorded on this certificate.**

	A	B	C	D	E	F	G	H	I	J	K	L	M
2	6		5		4		3		2		1		
3													
4	7		8		9		10		11		12		
5													
6	18		17		16		15		14		13		
7													
8	19		20		21		22		23		24		
9													
10	30		29		28		27		26		25		
11													
12	31		32		33		34		35		36		
13													

A. Description of original monument and accessories and/or subsequent restoration:


- 1843 Original Survey, John Mullett
- Set Wood Post
- 28" Yellow Pine N8°W 271ks
- 30" Yellow Pine S14°E 181ks
- 1931 Dependent Resurvey, Guy Veal
- 1964 USFS, Robert Griffin #13584

B. Description of corner evidence found and/or method applied in restoring or reestablishing corner:

- Fd. 3/4" solid iron bar
- Found 3 USFS Witnesses - bar checks within 3" on 3 witness distances
- Position accepted as most probable location of monument set in 1931 Dependent Resurvey

C. Description of monument for corner and accessories established to perpetuate locating the position of the corner:

- 5/8" by 30" rod with 3" dia. alumin cap
- USFS: NW Cor cabin S44°E 173.20'
- Cedar Post West 33'
- USFS nail & tag" 24" Red Oak S42°W 60.80'
- Cedar Post West 33'
- Fd. unidentified tag: Power Pole N81°W 43.00'
- Set nail & tag PS #16041 in:
- 20" Oak N50°E 55.35'
- Fd. 3/4" solid bart South 87.90'

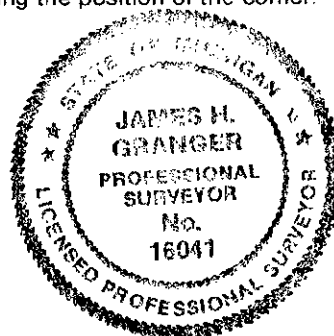

Signed by James H. Granger

Date Nov. 30, 1993

Surveyor's Michigan License No. 16041