

SURVEY & REMONUMENTATION

DEC 13 1993

**IOSCO COUNTY REMONUMENTATION CORNER
LAND CORNER RECORDATION CERTIFICATE**
Filing Requirement of Act 74, Mich. P.A. 1970

93-39

FILED

Dec 1 11 07 AM '93

REGISTER OF DEEDS
IOSCO COUNTY, MICH.
Brian M. Apple

Register of Deeds Stamp & File Number

For corners in

<u>Iosco</u> (County)	Located In:	Corner Code #
1. Public Land Survey	T <u>22N</u> R <u>6E</u>	<u>I-7</u>
	T _____ R _____	_____
	T _____ R _____	_____
	T _____ R _____	_____
2. Property Controlling in Section	S _____ T _____ R _____	_____
	S _____ T _____ R _____	_____
3. Miscellaneous Property in Sec.	S _____ T _____ R _____	_____
	S _____ T _____ R _____	_____

4. Lot No. _____, Recorded Plat _____
5. Private Claims _____

	A	B	C	D	E	F	G	H	I	J	K	L	M
2	6	5	4	3	2	1							
3													
4	7	8	9	10	11	12							
5													
6	18	17	16	15	14	13							
7													
8	19	20	21	22	23	24							
9													
10	30	29	28	27	26	25							
11													
12	31	32	33	34	35	36							
13													

I, James H. Granger, in a field survey on November 15-17, 19 93, do hereby certify that under requirements of P.A. 74, Michigan P.A. of 1970, the corner points mentioned in lines 1 and 2 above were in conformance with regulations and rules therefore as required in the current manual of survey instructions of the United States Department of the Interior, Bureau of Land Management or by a decree of a Court of Law and/or that the corner points mentioned in lines 3, 4 and 5 above were in conformance with the rules of the Michigan Board of Land Surveyors or by a Decree of a Court of Law; established, re-established, monumented, re-monumented, recovered, found as expressed below:

NOTE: Not more than 4 corners, all in the same town and range, may be recorded on this certificate.

A. Description of original monument and accessories and/or subsequent restoration:


1843 Original Survey, John Mullett
Set Wood Post
8" Beech N32°E 16 lks
12" Hemlock S61°W 13 lks
1900 Howard Belknap, Co. Surveyor
1900 Howard Belknap, Co. Surveyor
1931 Dependent Resurvey, Guy Veal

B. Description of corner evidence found and/or method applied in restoring or reestablishing corner:

Fd. 3/4" pipe and two witness tags LLS #30101
Checked position against fence in SW quadrant indicated in 1931 Dependent Resurvey with good agreement on position

C. Description of monument for corner and accessories established to perpetuate locating the position of the corner:

Set 5/8" dia by 30" steel bar with 3" dia aluminum cap
Set nail & tag PS #16041 in:
24" Oak S50°E 19.37'
8" White Pine N45°E 59.24'
12" White Pine N60°W 37.75'
6" Quad Birch S60°W 84.07'
Fence Post East 20.70' USFS tag

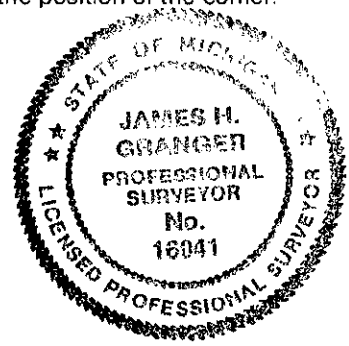

Signed by James H. Granger Date Nov. 30, 1993
Surveyor's Michigan License No. 16041