

**SURVEY & REMONUMENTATION**

DEC 13 1993

**IOSCO COUNTY REMONUMENTATION CORNER  
LAND CORNER RECORDATION CERTIFICATE**  
Filing Requirement of Act 74, Mich. P.A. 1970

REGISTRAR OF DEEDS  
IOSCO COUNTY, MICH.

*Richard L. Miller*

NOV 24 4 51 PM '93

93-12 FILED

For corners in

COMMISSION

IOSCO (County)	Located In:	Corner Code #
1. Public Land Survey	T <u>22N</u> R <u>6E</u>	<u>J-7</u>
	T _____ R _____	_____
	T _____ R _____	_____
	T _____ R _____	_____
2. Property Controlling in Section	S _____ T _____ R _____	_____
	S _____ T _____ R _____	_____
3. Miscellaneous Property in Sec.	S _____ T _____ R _____	_____
	S _____ T _____ R _____	_____
4. Lot No. _____, Recorded Plat _____		
5. Private Claims _____		

Register of Deeds Stamp & File Number

I, RICHARD L. MILLER in a field survey on OCTOBER 7, 19 93, do hereby certify that under requirements of P.A. 74, Michigan P.A. of 1970, the corner points mentioned in lines 1 and 2 above were in conformance with regulations and rules therefore as required in the current manual of survey instructions of the United States Department of the Interior, Bureau of Land Management or by a decree of a Court of Law and/or that the corner points mentioned in lines 3, 4 and 5 above were in conformance with the rules of the Michigan Board of Land Surveyors or by a Decree of a Court of Law; established, re-established, monumented, re-monumented, recovered, found as expressed below:

**NOTE: Not more than 4 corners, all in the same town and range, may be recorded on this certificate.**

	A	B	C	D	E	F	G	H	I	J	K	L	M
2	6		5		4		3		2		1		
3													
4	7		8		9		10		11		12		
5													
6	18		17		16		15		14		13		
7													
8	19		20		21		22		23		24		
9													
10	30		29		28		27		26		25		
11													
12	31		32		33		34		35		36		
13													

A. Description of original monument and accessories and/or subsequent restoration:


- 1843 ORIGINAL SUBDIVISION MULLETT & BURT SET WOOD POST 1964 U.S.F.S. ROBERT A. GRIFFIN R.L.S. #13584
- 14" ASPEN N.33 W. 12 LKS
- 10" MAPLE S.54 E. 11 LKS
- 1900 H.M. BELKNAP COUNTY SURVEYOR
- 1931 DEPENDANT RESURVEY GUY VEAL, APPROVED 1933
- SET 3 1/2" BRASS TABLET IN 6" DIAMETER CONCRETE CYLINDER, 24" LONG
- 9" N. PINE N.39 E. 50 LKS
- 4" W. OAK S.6 1/4 E. 51 LKS

B. Description of corner evidence found and/or method applied in restoring or reestablishing corner:

- FOUND 1931 MONUMENT IN ORIGINAL POSITION
- FOUND 1931 WITNESSES
- FOUND 1964 WITNESSES

C. Description of monument for corner and accessories established to perpetuate locating the position of the corner:

- 3 1/2" DIAMETER BRASS CAP IN 6" CONCRETE CYLINDER, 24" LONG
- 10" DOCK SPIKE IN N.W. SIDE 18" RED PINE N.39 E. 32.58' (1931 & 1964)
- 10" DOCK SPIKE IN N. SIDE 18" RED PINE N.82 E. 55.70' (1964)
- 10" DOCK SPIKE IN E. SIDE 19" W. OAK S.6 1/4 E. 33.52' (1931 & 1964)
- 10" DOCK SPIKE IN N.E. SIDE 10" W. PINE N.44 W. 27.70' (1964)

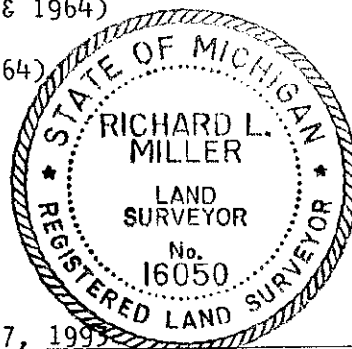

Signed by *Richard L. Miller*  
Surveyor's Michigan License No. 16050

Date NOVEMBER 17, 1993