

SURVEY & REMONUMENTATION

DEC 13 1993

COMMISSION

**IOSCO COUNTY REMONUMENTATION CORNER
LAND CORNER RECORDATION CERTIFICATE**
Filing Requirement of Act 74, Mich. P.A. 1970

REGISTER OF DEEDS
IOSCO COUNTY, MICH.

Richard L. Miller

Nov 24 4 32 PM '93

FILED
93-25

For corners in

IOSCO (County)	Located In:	Corner Code #
1. Public Land Survey	T 22N R 6E	K-7
	T R	
	T R	
	T R	
2. Property Controlling in Section	S T R	
	S T R	
3. Miscellaneous Property in Sec.	S T R	
	S T R	

Register of Deeds Stamp & File Number

4. Lot No. _____, Recorded Plat _____
5. Private Claims _____

	A	B	C	D	E	F	G	H	I	J	K	L	M
2	6	5	4	3	2	1							
3													
4	7	8	9	10	11	12							
5													
6	13	17	16	15	14	13							
7													
8	19	20	21	22	23	24							
9													
10	30	29	28	27	26	25							
11													
12	31	32	33	34	35	36							
13													

I, RICHARD L. MILLER in a field survey on OCTOBER 1, 19 93, do hereby certify that under requirements of P.A. 74, Michigan P.A. of 1970, the corner points mentioned in lines 1 and 2 above were in conformance with regulations and rules therefore as required in the current manual of survey instructions of the United States Department of the Interior, Bureau of Land Management or by a decree of a Court of Law and/or that the corner points mentioned in lines 3, 4 and 5 above were in conformance with the rules of the Michigan Board of Land Surveyors or by a Decree of a Court of Law; established, re-established, monumented, re-monumented, recovered, found as expressed below:

NOTE: Not more than 4 corners, all in the same town and range, may be recorded on this certificate.

A. Description of original monument and accessories and/or subsequent restoration:


- 1843 ORIGINAL SUBDIVISION MULLETT & BURT SET WOOD POST
18" Y. PINE S.34 W. 33 LKS
20" W. PINE N.57 E. 41 LKS
- 1900 H.M. BELKNAP COUNTY SURVEYOR
- 1931 DEPENDANT RESURVEY GUY VEAL, APPROVED 1933
SET 3 1/2" BRASS TABLET IN 6" DIAMETER CONCRETE CYLINDER, 24" LONG
4" W. OAK N.16 1/4 E. 46 1/2 LKS 10" B. OAK S.36 1/2 W. 101 LKS
12" B. OAK S.53 1/2 E. 83 LKS 7" B. OAK N.64 W. 78 LKS

B. Description of corner evidence found and/or method applied in restoring or reestablishing corner:

FOUND CORNER MONUMENT REPLACED BY GRIFFIN IN 1964. CORNER 6' EAST OF NORTH-SOUTH ROAD CENTERLINE.
FOUND 1 1931 WITNESS

C. Description of monument for corner and accessories established to perpetuate locating the position of the corner:

- 3" BRASS TABLET IN 6" ROUND REINFORCED CONCRETE POST 36" LONG 1' BELOW SURFACE OF ROAD
SET WITNESS TAG IN N.W. SIDE 14" OAK N.45 E. 76.18'
SET WITNESS TAG IN S.W. SIDE 10" OAK S.48 E. 38.71'
SET WITNESS TAG IN S.E. SIDE 12" OAK S.50 W. 46.77'
10" DOCK SPIKE IN N.E. SIDE 12" OAK N.64 W. 51.31' (1931 & 1964)

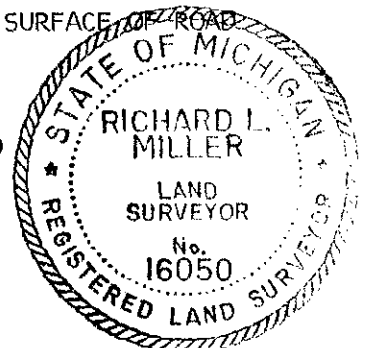

Signed by *Richard L. Miller*
Surveyor's Michigan License No. 16050

Date NOVEMBER 17, 1993