

SURVEY & REMONUMENTATION

FEB 16 1999

REMONUMENTATION CORNER

98-32

SECTION

LAND CORNER RECORDATION CERTIFICATE
Filing Requirement of Act 74, Mich. P.A. 1970

STATE OF MICHIGAN
IOSCO COUNTY
FILED

8 DEC 98 1:13 P.M.

DONITA M. COYLE
REGISTER OF DEEDS

For corners in

<u>IOSCO</u> (County)	Located In:	Corner Code #
1. Public Land Survey	T22N R6E	K-13
	T___ R___	_____
	T___ R___	_____
	T___ R___	_____
2. Property Controlling in Section	S___ T___ R___	_____
	S___ T___ R___	_____
3. Miscellaneous Property in Sec.	S___ T___ R___	_____
	S___ T___ R___	_____

Register of Deeds Stamp & File Number

	A	B	C	D	E	F	G	H	I	J	K	L	M
1													
2	6		5		4		3		2		1		
3													
4	7		8		9		10		11		12		
5													
6	18		17		16		15		14		13		
7													
8	19		20		21		22		23		24		
9													
10	30		29		28		27		26		25		
11													
12	31		32		33		34		35		36		
13													

4. Lot No. _____, Recorded Plat _____
5. Private Claims _____

I, JAMES H. GRANGER, in a field survey on SEPTEMBER 29, 19 98 do hereby state that under requirements of P.A. 74, Michigan P.A. of 1970, the corner points mentioned in lines 1 and 2 above were in conformance with regulations and rules therefore as required in the current manual of survey instructions of the United States Department of the Interior, Bureau of Land Management or by a decree of a Court of Law and for that the corner points mentioned in lines 3, 4 and 5 above were in conformance with the rules of the Michigan Board of Land Surveyors or by a Decree of a Court of Law; established, re-established, monumented, recovered, found as expressed below:

NOTE: Not more than 2 corners, all in the same town and range, may be recorded on this certificate.

A. Description of original monument and accessories and/or subsequent restoration:

1837 GLO
Lewis Clason set wood post N40°E 20 LKS
N13°W 34 LKS

B. Description of corner evidence found and/or method applied in restoring or reestablishing corner:

Field measured to approx location based on single proportionate measurement between SE cor. Sec. 36 and NW cor. Sec. 2, T21N, R6E. No original evidence found. Also evaluated against distances between NE cor. Sec. 1, T21N, R6E and NW cor. Sec. 2, T21N, R6E to establish consistency with measured vs. recorded distances. Establish cor. Location at 5,207.84 ft. West of Sec. 36.


C. Description of monument for corner and accessories established to perpetuate locating the position of the corner:

Set 5/8" x 24" iron rod w/ remon cap

Maple 12" dia.	S30°E	25.84'	nail and tag
Aspen 14" dia.	South	11.56'	nail and tag
Aspen 6" dia.	N60°W	30.20'	nail and tag
W. Birch 4" dia.	N60°E	25.23'	nail and tag
NW cor. Sec. 1	East	15.91'	remon cap T21N, R6E

ACCEPTED BY THE IOSCO COUNTY SURVEY PEER GROUP AS THE OFFICIAL CORNER UNDER P.A. 345 OF 1990 AT A MEETING HELD ON 9-22-98

James H. Granger

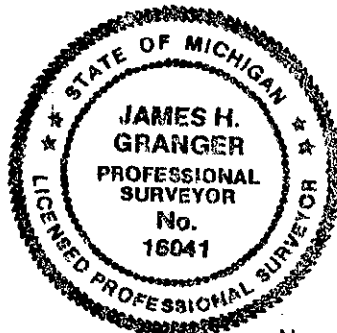

Signed by James H. Granger
Surveyor's Michigan License No. 16041

Date November 2, 1998