

**SURVEY & REMONUMENTATION**

DEC 13 1993

**IOSCO COUNTY REMONUMENTATION CORNER  
LAND CORNER RECORDATION CERTIFICATE**  
Filing Requirement of Act 74, Mich. P.A. 1970

For corners in

IOSCO (County)	Located In:	Corner Code #
1. Public Land Survey	T 22N R 6E	L-5
	T _____ R _____	_____
	T _____ R _____	_____
	T _____ R _____	_____
2. Property Controlling in Section	S _____ T _____ R _____	_____
	S _____ T _____ R _____	_____
3. Miscellaneous Property in Sec.	S _____ T _____ R _____	_____
	S _____ T _____ R _____	_____

REGISTER OF DEEDS  
 IOSCO COUNTY, MICH.  
 Nov 24 4 32 PM '93  
 FILED  
 93-26

Register of Deeds Stamp & File Number

4. Lot No. \_\_\_\_\_, Recorded Plat \_\_\_\_\_  
 5. Private Claims \_\_\_\_\_


	A	B	C	D	E	F	G	H	I	J	K	L	M
2	6		5		4		3		2		1		
3													
4	7		8		9		10		11		12		
5													
6	18		17		16		15		14		13		
7													
8	19		20		21		22		23		24		
9													
10	30		29		28		27		26		25		
11													
12	31		32		33		34		35		36		
13													

I, RICHARD L. MILLER, in a field survey on OCTOBER 5, 1993, do hereby certify that under requirements of P.A. 74, Michigan P.A. of 1970, the corner points mentioned in lines 1 and 2 above were in conformance with regulations and rules therefore as required in the current manual of survey instructions of the United States Department of the Interior, Bureau of Land Management or by a decree of a Court of Law and/or that the corner points mentioned in lines 3, 4 and 5 above were in conformance with the rules of the Michigan Board of Land Surveyors or by a Decree of a Court of Law; established, re-established, monumented, re-monumented, recovered, found as expressed below:

**NOTE: Not more than 4 corners, all in the same town and range, may be recorded on this certificate.**

- A. Description of original monument and accessories and/or subsequent restoration:
- 1843 ORIGINAL SUBDIVISION MULLETT & BURT  
SET WOOD POST  
12" Y. PINE N.85 E. 2.02 LKS
  - 1931 DEPENDANT RESURVEY GUY VEAL, APPROVED 1933  
SET 3 1/2" BRASS TABLET IN 6" DIAMETER CONCRETE CYLINDER, 24" LONG  
12" B. OAK S.42 3/4 W. 368 LKS  
10" J. PINE N82 W. 200 LKS  
FENCE COR. S.67 3/4 W. 36 LKS
  - 1964 U.S.F.S. ROBERT A. GRIFFIN R.L.S. #13584

- B. Description of corner evidence found and/or method applied in restoring or reestablishing corner:
- FOUND 1931 MONUMENT IN ORIGINAL POSITION 6" ABOVE GROUND
  - FOUND 1964 WITNESSES

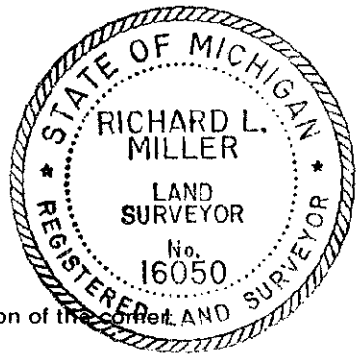

- C. Description of monument for corner and accessories established to perpetuate locating the position of the corner:
- 3 1/2" DIAMETER BRASS CAP IN 6" CONCRETE CYLINDER, 24" LONG
  - 10" DOCK SPIKE IN N.W. SIDE 10" R. PINE N.23 E. 66.10' (1964)
  - 10" DOCK SPIKE IN WEST SIDE 10" R. PINE S.04 W. 53.20' (1964)
  - 10" DOCK SPIKE IN S.W. SIDE 10" R. PINE N.35 W. 57.40' (1964)
  - 10" DOCK SPIKE IN N.W. SIDE 17" B. OAK STUMP S.42 3/4 W. 243.15' (1931 & 1964)
  - SET WITNESS TAG IN N.E. SIDE 20" B. OAK S.75 E. 64.90'

Signed by Richard L. Miller Date NOVEMBER 17, 1993  
 Surveyor's Michigan License No. 16050