

SURVEY & REMONUMENTATION

DEC 13 1993

COMMISSION.

IOSCO COUNTY REMONUMENTATION CORNER LAND CORNER RECORDATION CERTIFICATE
 Filing Requirement of Act 74, Mich. P.A. 1970

For corners in

<u>Iosco</u> (County)	Located In:	Corner Code #
1. Public Land Survey	T <u>22N</u> R <u>6E</u>	<u>M-4</u>
	T _____ R _____	_____
	T _____ R _____	_____
	T _____ R _____	_____
2. Property Controlling in Section	S _____ T _____ R _____	_____
	S _____ T _____ R _____	_____
3. Miscellaneous Property in Sec.	S _____ T _____ R _____	_____

4. Lot No. _____, Recorded Plat _____
 5. Private Claims _____

I, James H. Granger, in a field survey on November 15-17, 19 93, do hereby certify that under requirements of P.A. 74, Michigan P.A. of 1970, the corner points mentioned in lines 1 and 2 above were in conformance with regulations and rules therefore as required in the current manual of survey instructions of the United States Department of the Interior, Bureau of Land Management or by a decree of a Court of Law and/or that the corner points mentioned in lines 3, 4 and 5 above were in conformance with the rules of the Michigan Board of Land Surveyors or by a Decree of a Court of Law; established, re-established, monumented, re-monumented, recovered, found as expressed below:

NOTE: Not more than 4 corners, all in the same town and range, may be recorded on this certificate.

A. Description of original monument and accessories and/or subsequent restoration:


- 1838 Original Survey, Lewis Clason**
 - Set Wood Post
 - 8" Spruce Pine S28°W 5 lks
 - 9" Spruce Pine N85°W 28lks
- 1931 Dependent Resurvey, Guy Veal**

B. Description of corner evidence found and/or method applied in restoring or reestablishing corner:

- 1931 Monument Destroyed**
 - Set 5/8" by 30" rod with 3" dia. alumin cap
 - Established by single proportionate distance on line between the NE and NW Sec. corners
 - Fd. what appears to be stump of 1931 BT - position agrees with stump witness distance

C. Description of monument for corner and accessories established to perpetuate locating the position of the corner:

- 5/8" by 30" rod with 3" dia. alumin. cap
 - 12" Red Pine N56°E 33.79'
 - 12" Red Oak N45°W 73.21'
 - 12" Red Pine S72°W 48.21'
 - 12" Red Pine S32°E 38.17'
 - 33'± north to road centerline

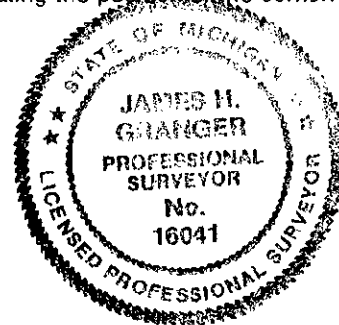

Signed by James H. Granger Date Nov 30, 1993
 Surveyor's Michigan License No. 16041

REGISTER OF DEEDS
 IOSCO COUNTY, MICH.
Benjamin H. Coyle

DEC 1 11 07 AM '93

FILED

93-40

Register of Deeds Stamp & File Number

	A	B	C	D	E	F	G	H	I	J	K	L	M
2	6	5	4	3	2	1							
3													
4	7	8	9	10	11	12							
5													
6	18	17	16	15	14	13							
7													
8	19	20	21	22	23	24							
9													
10	30	29	28	27	26	25							
11													
12	31	32	33	34	35	36							
13													