

**REMONUMENTATION CORNER
LAND CORNER RECORDATION CERTIFICATE
Filing Requirement of Act 74, Mich. P.A. 1970**

For corners in

<u>Iosco</u> (County)	Located In:	Corner Code #
1. Public Land Survey	<u>T22N R7E</u>	<u>G-13</u>
	T ___ R ___	_____
	T ___ R ___	_____
	T ___ R ___	_____
2. Property Controlling in Section	S ___ T ___ R ___	_____
	S ___ T ___ R ___	_____
3. Miscellaneous Property in Sec.	S ___ T ___ R ___	_____
	S ___ T ___ R ___	_____

STATE OF MICHIGAN
IOSCO COUNTY
FILED

3 DEC 97 11:50 A.M.

BONITA M. COYLE
REGISTER OF DEEDS

97-53

Register of Deeds Stamp & File Number

4. Lot No. _____, Recorded Plat _____
5. Private Claims _____

I, James H. Granger, in a field survey on August 4, 1997, do hereby state that under requirements of P.A. 74, Michigan P.A. of 1970, the corner points mentioned in lines 1 and 2 above were in conformance with regulations and rules therefore as required in the current manual of survey instructions of the United States Department of the Interior, Bureau of Land Management or by a decree of a Court of Law and /or that the corner points mentioned in lines 3, 4 and 5 above were in conformance with the rules of the Michigan Board of Land Surveyors or by a Decree of a Court of Law; established, re-established, monumented, recovered, found as expressed below:

NOTE: Not more than 2 corners, all in the same town and range, may be recorded on this certificate.

A	B	C	D	E	F	G	H	I	J	K	L	M
1												
2	6		5		4		3		2		1	
3												
4	7		8		9		10		11		12	
5												
6	18		17		16		15		14		13	
7												
8	19		20		21		22		23		24	
9												
10	30		29		28		27		26		25	
11												
12	31		32		33		34		35		36	
13												

A. Description of original monument and accessories and/or subsequent restoration:

1838	GLO	L. Clason	Set wood post	18" W. Pine	N39°E 10LKS
				7" Maple	N53°W 17LKS
1972		James Campbell	#15397	Plow Point	
1973		James Campbell	#15397	Plow Point	
1986		John Oliver	#19840	FD Plow Point	

B. Description of corner evidence found and/or method applied in restoring or reestablishing corner:

Found PK nail, also found "T" iron 17.14 ft West which is the NE Cor Sec. 4, T21N, R7E.
Excavation uncovered 1" pipe 0.4' below surface under PK nail.
Accept position as previously established.


ACCEPTED BY THE IOSCO COUNTY
SURVEY PEER GROUP AS THE
OFFICIAL CORNER UNDER P.A.
345 OF 1990 AT A MEETING
HELD ON 9-16-97

James H. Granger

C. Description of monument for corner and accessories established to perpetuate locating the position of the corner:

Set 5/8" rebar inside 1" Iron Pipe with Remon Cap in Mon Box.

3" Oak	N24°E	61.24'	nail & tag 16041
5" Box Elder	S37°E	54.48'	nail & tag 16041
Utility Pole	S48°W	55.75'	nail & tag 16041
20" Cottonwood	N48°W	94.03'	nail & tag 16041
G-1 Remon Cap in Mon Box West		17.14'	(T21N, R7E)

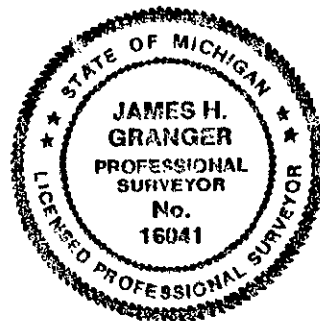

Signed by James H. Granger
Surveyor's Michigan License No. 16041

Date November 10, 1997

FORM APPROVED BY MICHIGAN STATE BOARD OF PROFESSIONAL SURVEYORS, JAN. 29, 1971
REVISED MAY 14, 1975

REVISED JAN., 1983
REVISED OCT., 1995

**SURVEY &
REMONUMENTATION**

MAR 18 1998

SECTION