

SURVEY &
REMONUMENTATION

MAY 07 1997

COMMISSION

1996 IOSCO COUNTY REMONUMENTATION
LAND CORNER RECORDATION CERTIFICATE
Filing Requirement of Act 74, Mich. P.A. 1970

96-34

For corners in

<u>Iosco</u> <small>(County)</small>	Located In:	Corner Code #/
1. Public Land Survey	T <u>22N</u> R <u>8E</u>	<u>A-2</u>
	T _____ R _____	_____
	T _____ R _____	_____
	T _____ R _____	_____
2. Property Controlling in Section	S _____ T _____ R _____	_____
	S _____ T _____ R _____	_____
3. Miscellaneous Property in Sec.	S _____ T _____ R _____	_____
	S _____ T _____ R _____	_____


STATE OF MICHIGAN
IOSCO COUNTY
FILED

5 NOV 96 4:27 P.M.

SONITA M. COYLE
REGISTER OF DEEDS
Register of Deeds Stamp & File Number

4. Lot No. _____, Recorded Plat _____
5. Private Claims _____

I, James H. Granger, in a field survey on October 24, 19 96, do hereby certify that under requirements of P.A. 74, Michigan P.A. of 1970, the corner points mentioned in lines 1 and 2 above were in conformance with regulations and rules therefore as required in the current manual of survey instructions of the United States Department of the Interior, Bureau of Land Management or by a decree of a Court of Law and/or that the corner points mentioned in lines 3, 4 and 5 above were in conformance with the rules of the Michigan Board of Land Surveyors or by a Decree of a Court of Law; established, re-established, monumented, re-monumented, recovered, found as expressed below:

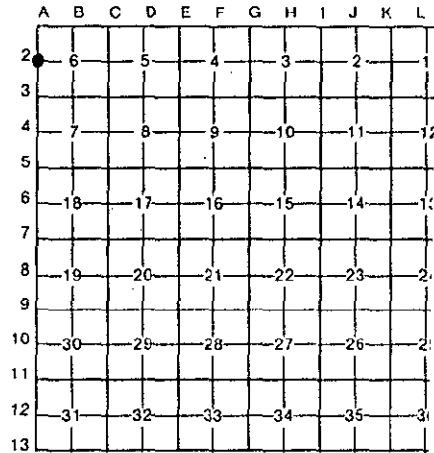

NOTE: Not more than 4 corners, all in the same town and range, may be recorded on this certificate.

A. Description of original monument and accessories and/or subsequent restoration:

1838 GLO Lewis Calson Set Wood Post
8" Birch S67°W 31 lks
5" Birch N68°W 32 lks

1920 Co. Surveyor John Applin #318 notes in Co. Surveyor's Book indicates corner position
1993 Private Survey James H. Granger #16041 Fd iron in Mon. box.

B. Description of corner evidence found and/or method applied in restoring or reestablishing corner:

Fd 3/4" bolt in Mon. box. No witnesses.

ACCEPTED BY THE IOSCO COUNTY
SURVEY PEER GROUP AS THE
OFFICIAL CORNER UNDER P.A.
345 OF 1990 AT A MEETING
HELD ON 10-23-96

James H. Granger

C. Description of monument for corner and accessories established to perpetuate locating the position of the corner:

5/8"x30" rebar w/ Remon Cap in Mon. box.

Fence corner	East	33.65'	nail & tag
6" Oak	S 30°E	88.87'	nail & tag
Fence corner	N 80°W	33.53'	nail & tag
4" Popple	N 50°E	41.26'	nail & tag

CORNER ALSO LOCATED IN:
T22N R7E M-2



Signed by James H. Granger Date October 28, 1996
Surveyor's Michigan License No. 16041