SURVEY
REMONUM

MAY 07 1997

COMMISSION

1996 IOSCO COUNTY REMONUMENTATION
LAND CORNER RECORDATION CERTIFICATE
Filing Requirement of Act 74, Mich. P.A. 1970

96-39

STATE OF MICHIGAN
IOSCO COUNTY
FILED

5 NOV 96 4:28 P.M.

BONITA M. COYLE
REGISTER OF DEEDS

Register of Deeds Stamp & File Number

For corners in Iosco (County)

		Located In:	Corner Code ##
1. Public Land Survey		T 22N R 8E	A-7
		T ___ R ___	
		T ___ R ___	
		T ___ R ___	
2. Property Controlling	S ___	T ___ R ___	
in Section	S ___	T ___ R ___	
3. Miscellaneous	S ___	T ___ R ___	
Property in Sec.	S ___	T ___ R ___	

4. Lot No. _____ , Recorded Plat _____
5. Private Claims _____

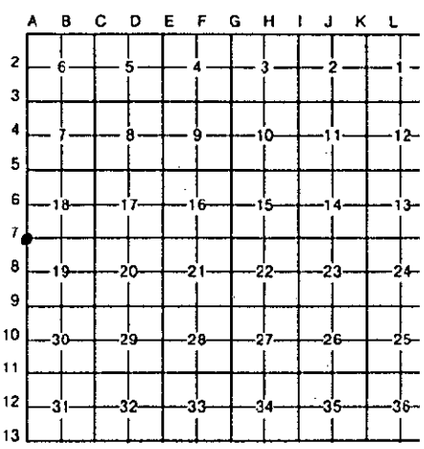

I, James H. Granger in a field survey on October 24, 19 96, do hereby certify that under requirements of P.A. 74, Michigan P.A. of 1970, the corner points mentioned in lines 1 and 2 above were in conformance with regulations and rules therefore as required in the current manual of survey instructions of the United States Department of the Interior, Bureau of Land Management or by a decree of a Court of Law and/or that the corner points mentioned in lines 3, 4 and 5 above were in conformance with the rules of the Michigan Board of Land Surveyors or by a Decree of a Court of Law; established, re-established, monumented, re-monumented, recovered, found as expressed below:

NOTE: Not more than 4 corners, all in the same town and range, may be recorded on this certificate.

A. Description of original monument and accessories and/or subsequent restoration:

1838 GLO Lewis Clason Set Wood Post 8" Spruce S65°W 27 lks
5" W. Pine N46°W 43 lks
1958 Sub'd. R.J. Cooke # 2335 indicates corner position.
1973 Private Survey James Campbell #15397 Indicates corner position.
1975 Private Survey James Campbell #15397 1/2" bolt in Mon. box.
1988 Private Survey Larry Beauregard #18854 Indicates corner position.

B. Description of corner evidence found and/or method applied in restoring or reestablishing corner:

Fd 1/4" bar in Mon. box. No witnesses.

ACCEPTED BY THE IOSCO COUNTY SURVEY PEER GROUP AS THE OFFICIAL CORNER UNDER P.A. 345 OF 1990 AT A MEETING HELD ON 10-23-96

James H Granger

C. Description of monument for corner and accessories established to perpetuate locating the position of the corner:

5/8"x30" rebar w/Remon. Cap in Mon. box.

Utility pole	S70°W	48.87'	nail & tag
Utility pole	N45°W	90.70'	nail & tag
Utility pole	N60°E	56.84'	nail & tag
Utility pole	S10°E	167.37'	nail & tag

CORNER ALSO LOCATED IN:
T22N R7E M-7

STATE OF MICHIGAN
JAMES H. GRANGER
PROFESSIONAL SURVEYOR
No. 16041
LICENSED PROFESSIONAL SURVEYOR

Signed by James H Granger Date October 28, 1996

Surveyor's Michigan License No. 16041

FORM APPROVED BY MICHIGAN STATE BOARD OF LAND SURVEYORS, JAN. 28, 197
REVISED MAY 14, 197
REVISED JAN., 198