

**SURVEY & REMONUMENTATION**

MAY 07 1997

COMMISSION

1996 IOSCO COUNTY REMONUMENTATION

LAND CORNER RECORDATION CERTIFICATE  
Filing Requirement of Act 74, Mich. P.A. 1970

96-33

For corners in

<u>Iosco</u> <small>(County)</small>	Located In:	Corner Code #	
1. Public Land Survey	T <u>22N</u> R <u>8E</u>	<u>A-1</u>	
	T _____ R _____	_____	
	T _____ R _____	_____	
	T _____ R _____	_____	
2. Property Controlling in Section	S _____ T _____ R _____	_____	
	S _____ T _____ R _____	_____	
3. Miscellaneous Property in Sec.	S _____ T _____ R _____	_____	
	S _____ T _____ R _____	_____	
4. Lot No. _____, Recorded Plat _____			
5. Private Claims _____			

STATE OF MICHIGAN  
IOSCO COUNTY  
FILED  
5 NOV 96 4:27 P.M.  
DONITA M. COYLE  
REGISTER OF DEEDS  
Stamp & File Number

I, James H. Granger in a field survey on October 24, 1996, do hereby certify that under requirements of P.A. 74, Michigan P.A. of 1970, the corner points mentioned in lines 1 and 2 above were in conformance with regulations and rules therefore as required in the current manual of survey instructions of the United States Department of the Interior, Bureau of Land Management or by a decree of a Court of Law and/or that the corner points mentioned in lines 3, 4 and 5 above were in conformance with the rules of the Michigan Board of Land Surveyors or by a Decree of a Court of Law; established, re-established, monumented, re-monumented, recovered, found as expressed below:

A	B	C	D	E	F	G	H	I	J	K	L	M
2	6	5	4	3	2	1						
3												
4	7	8	9	10	11	12						
5												
6	18	17	16	15	14	13						
7												
8	19	20	21	22	23	24						
9												
10	30	29	28	27	26	25						
11												
12	31	32	33	34	35	36						
13												

NOTE: Not more than 4 corners, all in the same town and range, may be recorded on this certificate.


A. Description of original monument and accessories and/or subsequent restoration:  
 1838 GLO Lewis Clason Set Wood Post  
 12" Cedar S62°W 21 lks  
 11" Hemlock N45°E 30 lks  
 1920 Co. Surveyor John Applin #318 notes in Co. Surveyor's Book indicates corner position.  
 1993 Private Survey James H. Granger #16041 Fd iron in Mon. box.

B. Description of corner evidence found and/or method applied in restoring or reestablishing corner:  
 Fd 3/4" iron in Mon. Box. No witnesses.

ACCEPTED BY THE IOSCO COUNTY SURVEY PEER GROUP AS THE OFFICIAL CORNER UNDER P.A. 345 OF 1990 AT A MEETING HELD ON 10-23-96

*James H. Granger*

C. Description of monument for corner and accessories established to perpetuate locating the position of the corner:  
 5/8" x 30" rebar inside 3/4" iron with Remon Cap in Mon. box.  
 4" Willow N75°W 171.18' nail & tag  
 Utility pole S45°W 96.80' nail & tag  
 Utility pole S60°E 122.85' nail & tag  
 12" Oak N65°E 153.32' nail & tag

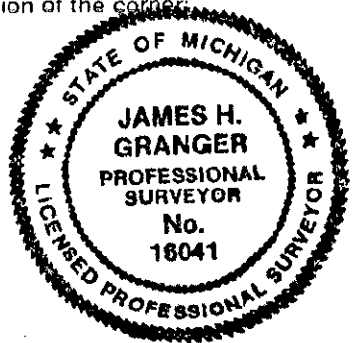

CORNER ALSO LOCATED IN:

- T23N R8E A-13
- T23N R7E M-13
- T22N R7E M-1

Signed by James H. Granger  
 Surveyor's Michigan License No. 16041

Date October 28, 1996