

MAY 07 1997

COMMISSION

**1996 IOSCO COUNTY REMONUMENTATION  
LAND CORNER RECORDATION CERTIFICATE  
Filing Requirement of Act 74, Mich. P.A. 1970**

**96-37**

For corners in

<u>Iosco</u> <small>(County)</small>	Located In:	Corner Code #
1. Public Land Survey	T <u>22N</u> R <u>8E</u>	<u>A-5</u>
	T _____ R _____	_____
	T _____ R _____	_____
	T _____ R _____	_____
2. Property Controlling in Section	S _____ T _____ R _____	_____
	S _____ T _____ R _____	_____
3. Miscellaneous Property in Sec.	S _____ T _____ R _____	_____
	S _____ T _____ R _____	_____

STATE OF MICHIGAN  
IOSCO COUNTY  
FILED

5 NOV 96 4:27 P.M.

BONITA M. COYLE  
REGISTER OF DEEDS

Register of Deeds Stamp & File Number

4. Lot No. \_\_\_\_\_, Recorded Plat \_\_\_\_\_  
5. Private Claims \_\_\_\_\_

	A	B	C	D	E	F	G	H	I	J	K	L	P
2	6	5	4	3	2	1							
3													
4	7	8	9	10	11	12							
5													
6	18	17	16	15	14	13							
7													
8	19	20	21	22	23	24							
9													
10	30	29	28	27	26	25							
11													
12	31	32	33	34	35	36							
13													

I, James H. Granger, in a field survey on October 24, 19 96, do hereby certify that under requirements of P.A. 74, Michigan P.A. of 1970, the corner points mentioned in lines 1 and 2 above were in conformance with regulations and rules therefore as required in the current manual of survey instructions of the United States Department of the Interior, Bureau of Land Management or by a decree of a Court of Law and/or that the corner points mentioned in lines 3, 4 and 5 above were in conformance with the rules of the Michigan Board of Land Surveyors or by a Decree of a Court of Law; established, re-established, monumented, re-monumented, recovered, found as expressed below:

**NOTE: Not more than 4 corners, all in the same town and range, may be recorded on this certificate.**

**A. Description of original monument and accessories and/or subsequent restoration:**

1838 GLO Lewis Clason Set Wood Post  
11" Cedar S 30°W 7 lks  
8" Spruce N 63°W 17 lks

1974 Private Survey James Campbell #15397 Fd 1" pipe in Mon. Box.

**B. Description of corner evidence found and/or method applied in restoring or reestablishing corner:**

Fd 1" pipe in Mon. box. No witnesses.


ACCEPTED BY THE IOSCO COUNTY  
SURVEY PEER GROUP AS THE  
OFFICIAL CORNER UNDER P.A.  
345 OF 1990 AT A MEETING  
HELD ON 10-23-96

*James H. Granger*

**C. Description of monument for corner and accessories established to perpetuate locating the position of the corner:**

5/8"x30" rebar inside 1" pipe w/Remon. Cap in Mon. box.  
P.K. Center of bridge North 62.52'  
Fence post N15°W 130.10' nail & tag  
10" Ash S75°E 41.18' nail & tag  
10" Tamarack N65°E 49.45' nail & tag

CORNER ALSO LOCATED IN:  
T22N R7E M-5

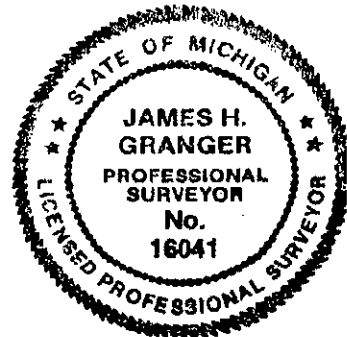

Signed by *James H. Granger*

Date October 28, 1996

Surveyor's Michigan License No. 16041