

SURVEY & REMONUMENTATION

APR 27 1995

COMMISSION

IOSCO COUNTY REMONUMENTATION CORNER LAND CORNER RECORDATION CERTIFICATE Filing Requirement of Act 74, Mich. P.A. 1970

STATE OF MICHIGAN
IOSCO COUNTY
FILED

For corners in

15 NOV 94 4:07 P.M.

BONITA H. COYLE
REGISTER OF DEEDS

94-18

Register of Deeds Stamp & File Number

Iosco (County)	Located In:	Corner Code #
1. Public Land Survey	T <u>22N</u> R <u>8E</u>	A - 9
	T _____ R _____	_____
	T _____ R _____	_____
	T _____ R _____	_____
2. Property Controlling in Section	S _____ T _____ R _____	_____
	S _____ T _____ R _____	_____
3. Miscellaneous Property in Sec.	S _____ T _____ R _____	_____
	S _____ T _____ R _____	_____
4. Lot No. _____, Recorded Plat _____		
5. Private Claims _____		

	A	B	C	D	E	F	G	H	I	J	K	L	M
2	6		5		4		3		2		1		
3													
4	7		8		9		10		11		12		
5													
6	18		17		16		15		14		13		
7													
8	19		20		21		22		23		24		
9													
10	30		29		28		27		26		25		
11													
12	31		32		33		34		35		36		
13													

I, James H. Granger, in a field survey on September, 19 94, do hereby certify that under requirements of P.A. 74, Michigan P.A. of 1970, the corner points mentioned in lines 1 and 2 above were in conformance with regulations and rules therefore as required in the current manual of survey instructions of the United States Department of the Interior, Bureau of Land Management or by a decree of a Court of Law and/or that the corner points mentioned in lines 3, 4 and 5 above were in conformance with the rules of the Michigan Board of Land Surveyors or by a Decree of a Court of Law; established, re-established, monumented, re-monumented, recovered, found as expressed below:

NOTE: Not more than 4 corners, all in the same town and range, may be recorded on this certificate.

A. Description of original monument and accessories and/or subsequent restoration:

1837 Original Survey	Set Wood Post	1975 Survey	Rod in mon. box
Lewis Clasen	6" Tamarack S50°W 20 lks	1976 Survey	P.K. nail in mon. box
	10" Maple N39°W 29 lks	1977 Survey	P.K. nail in iron box
1984 MDOT	1 1/4" iron pipe		
1948 Sub'd	Goldsmiths Add'n to Tawas City		
1959 Sub'd	Huron Gardens Sub'd of Tawas City		

B. Description of corner evidence found and/or method applied in restoring or reestablishing corner:

Found 1/2" rebar in iron box. Check position against previous surveys of record and sub'd. ties. Accepted position as found.


ACCEPTED BY THE IOSCO COUNTY
SURVEY PEER GROUP AS THE
OFFICIAL CORNER UNDER P.A.
345 OF 1990 AT A MEETING
HELD ON 10-10-94

James H. Granger

C. Description of monument for corner and accessories established to perpetuate locating the position of the corner:

Set 5/8" x 30" rebar with alum. cap inside mon. box

P P	N20°E	87.20'	fd. nail
P P	N10°W	71.65'	set nail & tag
P P	S20°E	63.40'	set nail & tag
8"	Ash Clump	S50°W	

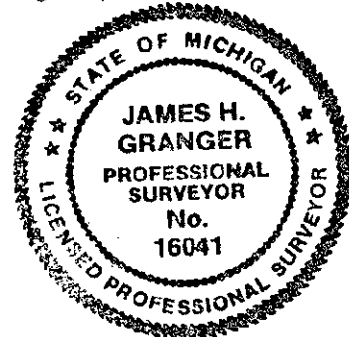

Signed by James H. Granger Date November 10, 1994
Surveyor's Michigan License No. 16041