

SURVEY & REMONUMENTATION

MAY 07 1997

COMMISSION

**1996 IOSCO COUNTY REMONUMENTATION
LAND CORNER RECORDATION CERTIFICATE
Filing Requirement of Act 74, Mich. P.A. 1970**

For corners in

<u>Iosco</u> (County)	Located In:	Corner Code #
1. Public Land Survey	T <u>22N</u> R <u>8E</u>	<u>C-1</u>
	T _____ R _____	_____
	T _____ R _____	_____
	T _____ R _____	_____
2. Property Controlling in Section	S _____ T _____ R _____	_____
	S _____ T _____ R _____	_____
3. Miscellaneous Property in Sec.	S _____ T _____ R _____	_____
	S _____ T _____ R _____	_____
4. Lot No. _____, Recorded Plat _____		
5. Private Claims _____		

96-46

STATE OF MICHIGAN
IOSCO COUNTY
FILED
Register of Deeds Stamp & File Number
5 NOV 96 4:29 P.M.

I, James H. Granger in a field survey on October 24, 19 96, do hereby certify that under requirements of P.A. 74, Michigan P.A. of 1970, the corner points mentioned in lines 1 and 2 above were in conformance with regulations and rules therefore as required in the current manual of survey instructions of the United States Department of the Interior, Bureau of Land Management or by a decree of a Court of Law and/or that the corner points mentioned in lines 3, 4 and 5 above were in conformance with the rules of the Michigan Board of Land Surveyors or by a Decree of a Court of Law; established, re-established, monumented, re-monumented, recovered, found as expressed below:

NOTE: Not more than 4 corners, all in the same town and range, may be recorded on this certificate.

	A	B	C	D	E	F	G	H	I	J	K	L	M
2	6	5	4	3	2	1							
3													
4	7	8	9	10	11	12							
5													
6	18	17	16	15	14	13							
7													
8	19	20	21	22	23	24							
9													
10	30	29	28	27	26	25							
11													
12	31	32	33	34	35	36							
13													

A. Description of original monument and accessories and/or subsequent restoration:

1837	GLO	Lewis Clason	Set Wood Post	8" Cedar	N 47° W	3 lks
				9" Cedar	N 19° E	28 lks
1973	Private Survey	Russell Small #13598		Fd 1" round bar		
1975	Private Survey	Russell Small #13598		Indicates corner position		
1993	Private Survey	John Oliver #19840		Fd 1" bar		
1993	Private Survey	James H. Granger #16041		Fd iron bar		

B. Description of corner evidence found and/or method applied in restoring or reestablishing corner:

Fd iron bar and four ex. witnesses.


ACCEPTED BY THE IOSCO COUNTY SURVEY PEER GROUP AS THE OFFICIAL CORNER UNDER P.A. 245 OF 1990 AT A MEETING HELD ON 10-23-96

James H. Granger

C. Description of monument for corner and accessories established to perpetuate locating the position of the corner:

5/8"x30" rebar w/Remon. Cap				
10 Red Pine	N 66° E	66.49'	ex. witness	
Fence Post	S 30° E	44.04'	ex. witness	
4" Beech	S 16° W	40.83'	ex. witness	
9" Ash	N 12° W	52.19'	ex. witness	

CORNER ALSO LOCATED IN:
T23N R8E C-13

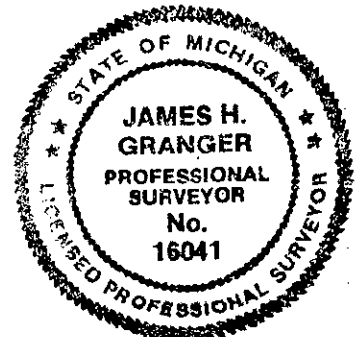

Signed by James H. Granger Date October 28, 1996
Surveyor's Michigan License No. 16041