

**SURVEY & REMONUMENTATION**

MAY 07 1997

COMMISSION

**1996 IOSCO COUNTY REMONUMENTATION  
LAND CORNER RECORDATION CERTIFICATE  
Filing Requirement of Act 74, Mich. P.A. 1970**

90-47

STATE OF MICHIGAN  
IOSCO COUNTY  
FILED

For corners in

Iosco (County)	Located In:	Corner Code #
1. Public Land Survey	T <u>22N</u> R <u>8E</u>	<u>C-2</u>
	T _____ R _____	_____
	T _____ R _____	_____
	T _____ R _____	_____
2. Property Controlling in Section	S _____ T _____ R _____	_____
	S _____ T _____ R _____	_____
3. Miscellaneous Property in Sec.	S _____ T _____ R _____	_____
	S _____ T _____ R _____	_____

5 NOV 96 4:29 P.M.

RONITA M. COYLE  
REGISTER OF DEEDS

Register of Deeds Stamp & File Number

4. Lot No. \_\_\_\_\_, Recorded Plat \_\_\_\_\_  
5. Private Claims \_\_\_\_\_

	A	B	C	D	E	F	G	H	I	J	K	L	M
2	6	●	5		4		3		2		1		
3													
4	7	8	9	10	11	12							
5													
6	18	17	16	15	14	13							
7													
8	19	20	21	22	23	24							
9													
10	30	29	28	27	26	25							
11													
12	31	32	33	34	35	36							
13													

I, James H. Granger in a field survey on October 24, 19 96, do hereby certify that under requirements of P.A. 74, Michigan P.A. of 1970, the corner points mentioned in lines 1 and 2 above were in conformance with regulations and rules therefore as required in the current manual of survey instructions of the United States Department of the Interior, Bureau of Land Management or by a decree of a Court of Law and/or that the corner points mentioned in lines 3, 4 and 5 above were in conformance with the rules of the Michigan Board of Land Surveyors or by a Decree of a Court of Law; established, re-established, monumented, re-monumented, recovered, found as expressed below:

**NOTE: Not more than 4 corners, all in the same town and range, may be recorded on this certificate.**

A. Description of original monument and accessories and/or subsequent restoration:

1843 GLO Lewis Clason Set Wood Post  
6" Aspen N 19° W 10 lks  
6" Birch S 38° E 7 lks  
1993 Private Survey James H. Granger #16041 1/2" rebar w/Cap #16041

B. Description of corner evidence found and/or method applied in restoring or reestablishing corner:


Found 1/2" rebar established by single proportionate measurement between NW and SW Sec. corners. Found 4 witnesses.

ACCEPTED BY THE IOSCO COUNTY  
SURVEY PEER GROUP AS THE  
OFFICIAL CORNER UNDER P.A.  
345 OF 1990 AT A MEETING  
HELD ON 10-23-96

*James H. Granger*

C. Description of monument for corner and accessories established to perpetuate locating the position of the corner:

5/8"x30" rebar w/Remon Cap.  
10" Red Pine N 68° E 42.21' nail & tag  
Fence Post S 64° E 44.04' nail & tag  
12" Ash S 16° W 61.48' nail & tag  
Fence Post S 86° W 40.12' nail & tag  
Centerline of Road East 13.50'

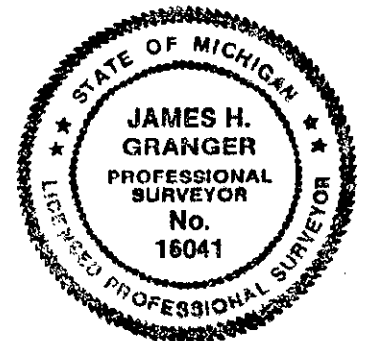

Signed by James H. Granger

Date October 28, 1996

Surveyor's Michigan License No. 16041