

FEB 22 1996

COMMISSION

IOSCO COUNTY REMONUMENTATION
LAND CORNER RECORDATION CERTIFICATE
Filing Requirement of Act 74, Mich. P.A. 1970

95-20

For corners in

iosco (County)	Located in:	Corner Code #
1. Public Land Survey	T <u>22N</u> R <u>8E</u>	<u>C - 8</u>
	T ___ R ___	_____
	T ___ R ___	_____
	T ___ R ___	_____
2. Property Controlling in Section	S ___ T ___ R ___	_____
	S ___ T ___ R ___	_____
3. Miscellaneous Property in Sec.	S ___ T ___ R ___	_____

STATE OF MICHIGAN
IOSCO COUNTY
FILED

12 DEC 95 2:22 P.M.

BONITA M. COYLE
REGISTER OF DEEDS

Registrar of Deeds Stamp & File Number

4. Lot No. _____, Recorded Plat _____
5. Private Claims _____

I, James H. Granger, in a field survey on Nov. 3, 1995 do hereby state that under requirements of P.A. 74, Michigan P.A. of 1970, the corner points mentioned in lines 1 and 2 above were in conformance with regulations and rules therefore as required in the current manual of survey instructions of the United States Department of the Interior, Bureau of Land Management or by a decree of a Court of Law and /or that the corner points mentioned in lines 3, 4 and 5 above were in conformance with the rules of the Michigan Board of Land Surveyors or by a Decree of a Court of Law; established, re-established, monumented, recovered, found as expressed below:

1	A	B	C	D	E	F	G	H	I	J	K	L
2		6		5		4		3		2		1
3												
4		7		8		9		10		11		12
5												
6		13		17		16		15		14		13
7												
8		18		20		21		22		23		24
9												
10		30		29		28		27		26		25
11												
12		31		32		33		34		35		36
13												

NOTE: Not more than 2 corners, all in the same town and range, may be recorded on this certificate.

A. Description of original monument and accessories and/or subsequent restoration:

1837 Original Survey	Wood Post		
	6" Cedar	S 73% ^d E	21 lks.
	6" Cedar	S 3% ^d E	42 lks.

B. Description of corner evidence found and/or method applied in restoring or reestablishing corner:


No evidence found on original corner.
Reestablished by single proportionate distance between the NE and SE Sec. corners.

ACCEPTED BY THE IOSCO COUNTY
SURVEY PEER GROUP AS THE
OFFICIAL CORNER UNDER P.A.
345 OF 1990 AT A MEETING
HELD ON 10-31-95

James H. Granger

C. Description of monument for corner and accessories established to perpetuate locating the position of the corner:

5/8" x 30" Rebar with aluminum cap			
8" Jack Pine	South	18.21'	Set nail and tag
10" Twin Box Elder	North	22.25'	Set nail and tag
8" Ash	S 40% ^d W	18.45'	Set nail and tag
4" Oak	N 20% ^d W	33.33'	Set nail and tag

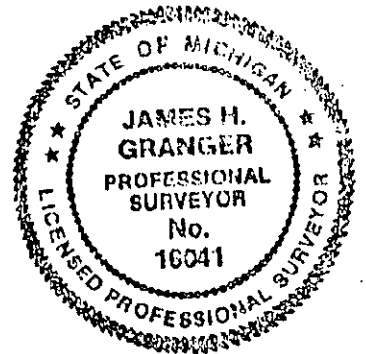

Signed by James H. Granger Date December 6, 1995
Surveyor's Michigan License No. 16041