

# SURVEY & REMONUMENTATION

APR 27 1995

COMMISSION

## IOSCO COUNTY REMONUMENTATION CORNER LAND CORNER RECORDATION CERTIFICATE Filing Requirement of Act 74, Mich. P.A. 1970

For corners in

Iosco (County)	Located In:	Corner Code -#
1. Public Land Survey	T 22N R 8E	C - 9
	T _____ R _____	_____
	T _____ R _____	_____
	T _____ R _____	_____
2. Property Controlling in Section	S _____ T _____ R _____	_____
	S _____ T _____ R _____	_____
3. Miscellaneous Property in Sec.	S _____ T _____ R _____	_____
	S _____ T _____ R _____	_____

STATE OF MICHIGAN  
IOSCO COUNTY  
FILED

15 NOV 94 4:04 P.M.

RONITA M. COYLE  
REGISTER OF DEEDS

**94-15**

Register of Deeds Stamp & File Number

4. Lot No. \_\_\_\_\_, Recorded Plat \_\_\_\_\_  
5. Private Claims \_\_\_\_\_

I, James H. Granger, in a field survey on September, 19 94, do hereby certify that under requirements of P.A. 74, Michigan P.A. of 1970, the corner points mentioned in lines 1 and 2 above were in conformance with regulations and rules therefore as required in the current manual of survey instructions of the United States Department of the Interior, Bureau of Land Management or by a decree of a Court of Law and/or that the corner points mentioned in lines 3, 4 and 5 above were in conformance with the rules of the Michigan Board of Land Surveyors or by a Decree of a Court of Law; established, re-established, monumented, re-monumented, recovered, found as expressed below:

	A	B	C	D	E	F	G	H	I	J	K	L	M
2	6		5		4		3		2		1		
3													
4	7		8		9		10		11		12		
5													
6	18		17		16		15		14		13		
7													
8	19		20		21		22		23		24		
9													
10	30		29		28		27		26		25		
11													
12	31		32		33		34		35		36		
13													

**NOTE: Not more than 4 corners, all in the same town and range, may be recorded on this certificate.**

A. Description of original monument and accessories and/or subsequent restoration:

1843 Original Survey John Mullett	Set Wood Post No witnesses	1944 Sub'd	Trustee's Plat of Currey's Add'n to East Tawas
1886 Sub'd	Joseph Dimmick's Add'n to East Tawas	1965 MDOT	3/4" iron pipe
1888 Sub'd	Alice Dimmick's Add'n to East Tawas	1977 Survey	3/4" iron pipe
1937 MDOT	US-23 road plans		

B. Description of corner evidence found and/or method applied in restoring or reestablishing corner:


Found 3/4" pipe 18" below surface. Found three previous witnesses. Checked against previous surveys and sub'd. ties. Accepted position.

ACCEPTED BY THE IOSCO COUNTY  
SURVEY PEER GROUP AS THE  
OFFICIAL CORNER UNDER P.A.  
345 OF 1990 AT A MEETING  
HELD ON 10-10-94

*James H. Granger*

C. Description of monument for corner and accessories established to perpetuate locating the position of the corner:

Set 5/8" x 30" rebar with alum. cap inside fnd 3/4" pipe  
NW cor Bldg N87°E 122.12' ex. spike & cap  
SW cor chimney S63°E 283.10' ex. tie  
6"-10" Maple cluster S15°W 105.93' set nail & tag  
24" W. Pine S70°W 197.28' set nail & tag  
12" Ash N5°W 108.42' set nail & tag

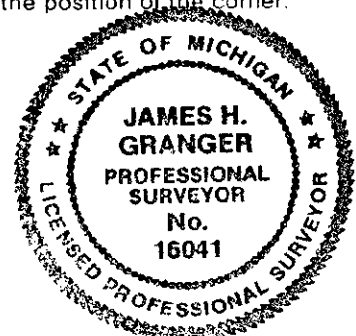

Signed by James H. Granger Date November 10, 1994  
Surveyor's Michigan License No. 16041