

**SURVEY &  
REMONUMENTATION**

MAY 07 1997

**COMMISSION**

**1996 IOSCO COUNTY REMONUMENTATION  
LAND CORNER RECORDATION CERTIFICATE  
Filing Requirement of Act 74, Mich. P.A. 1970**

**96-50**

For corners in

<u>Iosco</u> (County)	Located In:	Corner Code #
1. Public Land Survey	T <u>22</u> N R <u>8E</u>	<u>D-1</u>
	T _____ R _____	_____
	T _____ R _____	_____
	T _____ R _____	_____
2. Property Controlling in Section	S _____ T _____ R _____	_____
	S _____ T _____ R _____	_____
3. Miscellaneous Property in Sec.	S _____ T _____ R _____	_____
	S _____ T _____ R _____	_____

STATE OF MICHIGAN  
IOSCO COUNTY  
FILED

5 NOV 96 4:30 P.M.

RONITA M. COYLE  
REGISTER OF DEEDS

**Register of Deeds Stamp & File Number**

4. Lot No. \_\_\_\_\_, Recorded Plat \_\_\_\_\_

5. Private Claims \_\_\_\_\_

I, JAMES H. GRANGER, in a field survey on October 24, 1996 do hereby state that under requirements of P.A. 74, Michigan P.A. of 1970, the corner points mentioned in lines 1 and 2 above were in conformance with regulations and rules therefore as required in the current manual of survey instructions of the United States Department of the Interior, Bureau of Land Management or by a decree of a Court of Law and /or that the corner points mentioned in lines 3, 4 and 5 above were in conformance with the rules of the Michigan Board of Land Surveyors or by a Decree of a Court of Law; established, re-established, monumented, recovered, found as expressed below:

**NOTE: Not more than 2 corners, all in the same town and range, may be recorded on this certificate.**

1	A	B	C	D	E	F	G	H	I	J	K	L	M
2		6		5		4		3		2		1	
3													
4		7		8		9		10		11		12	
5													
6		18		17		16		15		14		13	
7													
8		19		20		21		22		23		24	
9													
10		30		29		28		27		26		25	
11													
12		31		32		33		34		35		36	
13													

A. Description of original monument and accessories and/or subsequent restoration:

1837 GLO Lewis Clason	Set Wood Post		
	7" Cedar	N 17°W	5 lks
	12" W. Pine	N 70°E	19 lks

ACCEPTED BY THE IOSCO COUNTY  
SURVEY PEER GROUP AS THE  
OFFICIAL CORNER UNDER P.A.  
345 OF 1990 AT A MEETING  
HELD ON 10-23-96


*James H. Granger*

B. Description of corner evidence found and/or method applied in restoring or reestablishing corner:

No original evidence found. Reestablished position by single proportionate measurement from NE/NW Sec. Corners. Position falls approx. 79' south of E-W road centerline.

C. Description of monument for corner and accessories established to perpetuate locating the position of the corner:

5/8" x 30" rebar w/Remon Cap			
8" W. Pine	N 15° W	12.92'	nail & tag
Fence Post	N 5° W	33.95'	nail & tag
12" Jack Pine	N 85° E	12.78'	nail & tag
Utility Pole	North	124.90'	nail & tag

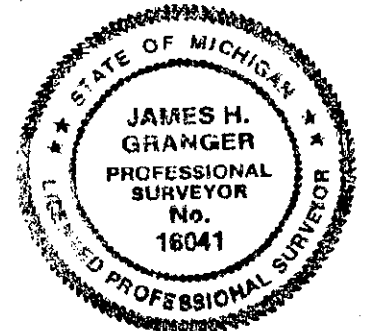

**CORNER ALSO LOCATED IN:**  
T23N R8E D-13

Signed by James H. Granger  
Surveyor's Michigan License No. 16041

Date October 28, 1996