

FF 3-2 1996

IOSCO COUNTY REMONUMENTATION  
LAND CORNER RECORDATION CERTIFICATE  
Filing Requirement of Act 74, Mich. P.A. 1970

95-21

For corners in

Lococo (County)	Located In:	Corner Code #
1. Public Land Survey	T22N R 8E	D-7
	T ___ R ___	_____
	T ___ R ___	_____
	T ___ R ___	_____
2. Property Controlling in Section	S ___ T ___ R ___	_____
	S ___ T ___ R ___	_____
3. Miscellaneous Property In Sec.	S ___ T ___ R ___	_____
	S ___ T ___ R ___	_____

STATE OF MICHIGAN  
IOSCO COUNTY  
FILED

12 DEC 95 2:23 P.M.

BONITA M. COYLE  
REGISTER OF DEEDS

Register of Deeds Stamp & File Num

4. Lot No. \_\_\_\_\_, Recorded Plat \_\_\_\_\_  
5. Private Claims \_\_\_\_\_

I, James H. Granger, in a field survey on Nov. 3, 1995 do hereby state that under requirements of P.A. 74, Michigan P.A. of 1970, the corner points mentioned in lines 1 and 2 above were in conformance with regulations and rules therefore as required in the current manual of survey instructions of the United States Department of the Interior, Bureau of Land Management or by a decree of a Court of Law and /or that the corner points mentioned in lines 3, 4 and 5 above were in conformance with the rules of the Michigan Board of Land Surveyors or by a Decree of a Court of Law; established, re-established, monumented, recovered, found as expressed below:

NOTE: Not more than 2 corners, all in the same town and range, may be recorded on this certificate.

	A	B	C	D	E	F	G	H	I	J	K	L
1												
2	6		5			4		3		2		1
3												
4	7					8		9		10		11
5												
6	16					17		16		15		14
7												
8	19					20		21		22		23
9												
10	30					29		28		27		26
11												
12	31					32		33		34		35
13												

A. Description of original monument and accessories and/or subsequent restoration:

1837 Original Survey	Wood Post			
	8" Cedar	N 62%°d W	10 lks.	
	8" Cedar	S 42%°d E	11 lks.	

1957 Subdivision  
1967 Subdivision  
1975 Subdivision  
1978 Private Survey  
1989 Private Survey

B. Description of corner evidence found and/or method applied in restoring or reestablishing corner:

Found 1/2" pipe and witnesses previously established.


ACCEPTED BY THE IOSCO COUNTY  
SURVEY PEER GROUP AS THE  
OFFICIAL CORNER UNDER P.A.  
345 OF 1990 AT A MEETING  
HELD ON 10-31-95

*James H. Granger*

C. Description of monument for corner and accessories established to perpetuate locating the position of the corner:

5/8" x 30" Rebar with aluminum cap

P.P.	N 45%°d E	37.00'	Set nail and tag
8" Maple	N 45%°d W	59.18'	Set nail and tag
6" Maple	S 40%°d W	56.91'	Set nail and tag
P.P.	S 40%°d E	44.88'	Set nail and tag

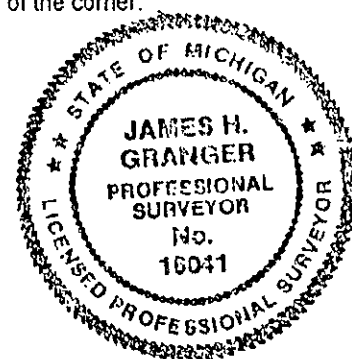

Signed by James H. Granger  
Surveyor's Michigan License No. 16041

Date December 6, 1995