

SURVEY &  
REMONUMENTATION

MAY 07 1997

COMMISSION

1996 IOSCO COUNTY REMONUMENTATION  
LAND CORNER RECORDATION CERTIFICATE  
Filing Requirement of Act 74, Mich. P.A. 1970

96-51

For corners in

Iosco (County)	Located In:	Corner Code #
1. Public Land Survey	T <u>22N</u> R <u>8E</u>	<u>E-1</u>
	T _____ R _____	_____
	T _____ R _____	_____
	T _____ R _____	_____
2. Property Controlling in Section	S _____ T _____ R _____	_____
	S _____ T _____ R _____	_____
3. Miscellaneous Property in Sec.	S _____ T _____ R _____	_____
	S _____ T _____ R _____	_____
4. Lot No. _____, Recorded Plat _____		
5. Private Claims _____		

STATE OF MICHIGAN  
IOSCO COUNTY  
FILED

5 NOV 96 4:30 P.M.

BONITA M. COYLE  
REGISTER OF DEEDS

Register of Deeds Stamp & File Number

I, James H. Granger, in a field survey on October 24, 19 96, do hereby certify that under requirements of P.A. 74, Michigan P.A. of 1970, the corner points mentioned in lines 1 and 2 above were in conformance with regulations and rules therefore as required in the current manual of survey instructions of the United States Department of the Interior, Bureau of Land Management or by a decree of a Court of Law and/or that the corner points mentioned in lines 3, 4 and 5 above were in conformance with the rules of the Michigan Board of Land Surveyors or by a Decree of a Court of Law; established, re-established, monumented, re-monumented, recovered, found as expressed below:

**NOTE: Not more than 4 corners, all in the same town and range, may be recorded on this certificate.**

	A	B	C	D	E	F	G	H	I	J	K	L	M
2	6		5		4		3		2		1		
3													
4	7		8		9		10		11		12		
5													
6	18		17		16		15		14		13		
7													
8	19		20		21		22		23		24		
9													
10	30		29		28		27		26		25		
11													
12	31		32		33		34		35		36		
13													

A. Description of original monument and accessories and/or subsequent restoration:

1837 GLO Lewis Clason Set Wood Post  
10" Tamarack N 42° W 17 lks  
6" Cedar N 49° E 18 lks

1975 Private Survey James Campbell #15397 Fd 1/2" pipe  
1993 Private Survey James H. Granger #16041 Fd 1" pipe

B. Description of corner evidence found and/or method applied in restoring or reestablishing corner:

Found 1" pipe. No witnesses. Measurements to E. and W. agreed reasonably well with GLO distances.


ACCEPTED BY THE IOSCO COUNTY  
SURVEY PEER GROUP AS THE  
OFFICIAL CORNER UNDER P.A.  
345 OF 1990 AT A MEETING  
HELD ON 10-23-96

*James H. Granger*

C. Description of monument for corner and accessories established to perpetuate locating the position of the corner:

5/8"x30" rebar inside 1" pipe w/Remon. Cap  
10" Apple tree S 25° E 37.80' nail & tag  
14" W. Pine S 45° E 55.13' nail & tag  
8" Popple N 57° E 52.47' nail & tag  
8" Blue Spruce N 25° W 73.72' nail & tag

CORNER ALSO LOCATED IN:  
T 23 N, R 6 E E-13

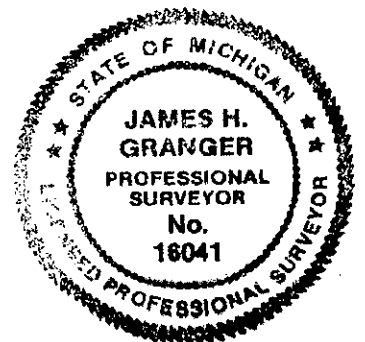

Signed by James H. Granger Date October 28, 1996  
Surveyor's Michigan License No. 16041