

**SURVEY &  
REMONUMENTATION**

APR 27 1995

**COMMISSION**

**IOSCO COUNTY REMONUMENTATION CORNER  
LAND CORNER RECORDATION CERTIFICATE**

Filing Requirement of Act 74, Mich. P.A. 1970

STATE OF MICHIGAN  
IOSCO COUNTY  
FILED

15 NOV 94 4:02 P.M.

BONITA M. COYLE  
REGISTER OF DEEDS

**94-11**


Register of Deeds Stamp & File Number

For corners in

Iosco (County)	Located In:	Corner Code #
1. Public Land Survey	T <u>22</u> N R <u>8E</u>	<u>G - 7</u>
	T _____ R _____	_____
	T _____ R _____	_____
	T _____ R _____	_____
2. Property Controlling in Section	S _____ T _____ R _____	_____
	S _____ T _____ R _____	_____
3. Miscellaneous Property in Sec.	S _____ T _____ R _____	_____
	S _____ T _____ R _____	_____

4. Lot No. \_\_\_\_\_, Recorded Plat \_\_\_\_\_  
5. Private Claims \_\_\_\_\_

I, James H. Granger, in a field survey on September, 19 94, do hereby certify that under requirements of P.A. 74, Michigan P.A. of 1970, the corner points mentioned in lines 1 and 2 above were in conformance with regulations and rules therefore as required in the current manual of survey instructions of the United States Department of the Interior, Bureau of Land Management or by a decree of a Court of Law and/or that the corner points mentioned in lines 3, 4 and 5 above were in conformance with the rules of the Michigan Board of Land Surveyors or by a Decree of a Court of Law; established, re-established, monumented, re-monumented, recovered, found as expressed below:

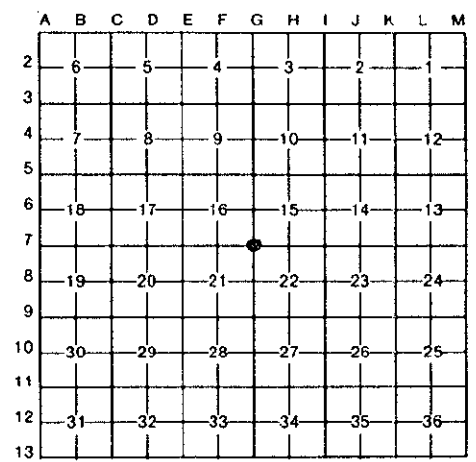

**NOTE: Not more than 4 corners, all in the same town and range, may be recorded on this certificate.**

**A. Description of original monument and accessories and/or subsequent restoration:**

1843 Original Survey	Set Wood Post
John Mullett	16" Yellow Pine N28°E 50 lks
	12" Yellow Pine S11°W 29 lks
1973 Survey	mon. found

**B. Description of corner evidence found and/or method applied in restoring or reestablishing corner:**

Found concrete monument previously recorded. Accepted position as found


ACCEPTED BY THE IOSCO COUNTY  
SURVEY PEER GROUP AS THE  
OFFICIAL CORNER UNDER P.A.  
345 OF 1990 AT A MEETING  
HELD ON 10-10-94

*James H. Granger*

**C. Description of monument for corner and accessories established to perpetuate locating the position of the corner:**

Concrete Mon. with alum. cap

Power Pole N15°W 42.49'	Set nail & tag
24" Red Pine S85°W 34.48'	find nail & tag
30" White Pine S5°E 48.53'	Set nail & tag
12" Oak E 32.64'	Set nail & tag

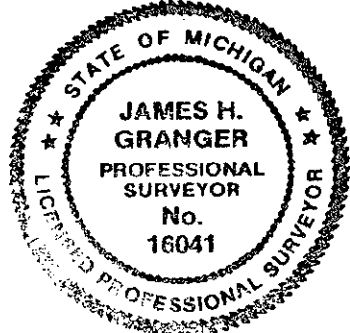

Signed by James H. Granger

Date November 10, 1994

Surveyor's Michigan License No. 16041