

SURVEY & REMONUMENTATION

APR 27 1995

COMMISSION

**IOSCO COUNTY REMONUMENTATION CORNER
LAND CORNER RECORDATION CERTIFICATE
Filing Requirement of Act 74, Mich. P.A. 1970**

STATE OF MICHIGAN
IOSCO COUNTY
FILED
15 NOV 94 4:02 P.M.

BONITA M. COYLE
REGISTER OF DEEDS

For corners in

Iosco (County)	Located In:	Corner Code #
1. Public Land Survey	T 22N R 8E	G - 8
	T _____ R _____	_____
	T _____ R _____	_____
	T _____ R _____	_____
2. Property Controlling in Section	S _____ T _____ R _____	_____
	S _____ T _____ R _____	_____
3. Miscellaneous Property in Sec.	S _____ T _____ R _____	_____
	S _____ T _____ R _____	_____

94-11

Register of Deeds Stamp & File Number

4. Lot No. _____, Recorded Plat _____
5. Private Claims _____

	A	B	C	D	E	F	G	H	I	J	K	L	M
2	6	5	4	3	2								
3													
4	7	8	9	10	11	12							
5													
6	18	17	16	15	14	13							
7													
8	19	20	21	22	23	24							
9													
10	30	29	28	27	26	25							
11													
12	31	32	33	34	35	36							
13													

I, James H. Granger, in a field survey on September, 19 94, do hereby certify that under requirements of P.A. 74, Michigan P.A. of 1970, the corner points mentioned in lines 1 and 2 above were in conformance with regulations and rules therefore as required in the current manual of survey instructions of the United States Department of the Interior, Bureau of Land Management or by a decree of a Court of Law and/or that the corner points mentioned in lines 3, 4 and 5 above were in conformance with the rules of the Michigan Board of Land Surveyors or by a Decree of a Court of Law; established, re-established, monumented, re-monumented, recovered, found as expressed below:

NOTE: Not more than 4 corners, all in the same town and range, may be recorded on this certificate.

- A. Description of original monument and accessories and/or subsequent restoration:
1843 Original Survey Cor. is 18" Spruce
John Mullett

1990 Survey 4" Sq. Conc. Mon.


- B. Description of corner evidence found and/or method applied in restoring or reestablishing corner:
Found 4" sq. conc. mon. as previously recorded. Accepted position as found.

ACCEPTED BY THE IOSCO COUNTY SURVEY PEER GROUP AS THE OFFICIAL CORNER UNDER P.A. 345 OF 1990 AT A MEETING HELD ON 10-10-94

James H. Granger

- C. Description of monument for corner and accessories established to perpetuate locating the position of the corner:

- 4" sq. concrete mon. with alum. cap
- 10" Maple S65°W 7.30' fd nail with ribbon
- 8" Birch N60°W 19.13' fd nail with tag
- 6" White Pine N30°E 6.18' fd nail with tag
- 16" Triple Maple S65°E 12.50' fd nail with tag

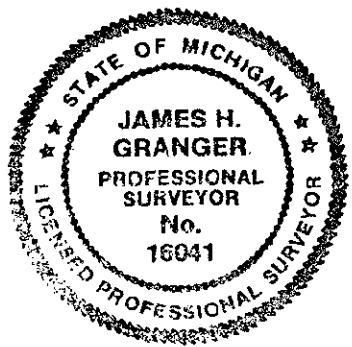

Signed by James H. Granger Date November 10, 1994

Surveyor's Michigan License No. 16041