

SURVEY & REMONUMENTATION

APR 27 1995

COMMISSION

IOSCO COUNTY REMONUMENTATION CORNER LAND CORNER RECORDATION CERTIFICATE Filing Requirement of Act 74, Mich. P.A. 1970

STATE OF MICHIGAN
IOSCO COUNTY
FILED

For corners in

15 NOV 94 4:02 P.M.

BONITA H. COYLE
REGISTER OF DEEDS

94-10

Register of Deeds Stamp & File Number

Iosco (County)	Located In:	Corner Code #
1. Public Land Survey	T 22N R 8E	G - 9
	T R	
	T R	
	T R	
2. Property Controlling in Section	S T R	
	S T R	
3. Miscellaneous Property in Sec.	S T R	
	S T R	

4. Lot No. _____, Recorded Plat _____

5. Private Claims _____

	A	B	C	D	E	F	G	H	I	J	K	L	M
2	6	5	4	3	2	1							
3													
4	7	8	9	10	11	12							
5													
6	18	17	16	15	14	13							
7													
8	19	20	21	22	23	24							
9													
10	30	29	28	27	26	25							
11													
12	31	32	33	34	35	36							
13													

James H. Granger, in a field survey on September 19 94

Do hereby certify that under requirements of P.A. 74, Michigan P.A. of 1970, the corner points mentioned in lines 1 and 2 above were in conformance with regulations and rules therefore as required in the current manual of survey instructions of the United States Department of the Interior, Bureau of Land Management or by a decree of a Court of Law and/or that the corner points mentioned in lines 3, 4 and 5 above were in conformance with the rules of the Michigan Board of Land Surveyors or by a Decree of a Court of Law; established, re-established, monumented, re-monumented, recovered, found as expressed below:

NOTE: Not more than 4 corners, all in the same town and range, may be recorded on this certificate.

A. Description of original monument and accessories and/or subsequent restoration:

1843 Original Survey	Set Wood Post
John Mullett	10" White Pine N61°W 18 lks
	8" Yellow Pine S53°E 17 lks
1934 Sub'd	Forest Glen
1990 Survey	4" conc. mon.

B. Description of corner evidence found and/or method applied in restoring or reestablishing corner:


Found 4" conc. mon. as previously recorded. Accepted position as established.

ACCEPTED BY THE IOSCO COUNTY
SURVEY PEER GROUP AS THE
OFFICIAL CORNER UNDER P.A.
345 OF 1990 AT A MEETING
HELD ON 10-10-94

James H. Granger

C. Description of monument for corner and accessories established to perpetuate locating the position of the corner:

4" Concrete mon. with alum. cap	
Fence post	N. 127.45' nail with tag
Fence post	E. 1.38' nail with tag
4" Cedar	W. 1.63' nail with tag
P P	N5°E 29.61' nail with tag

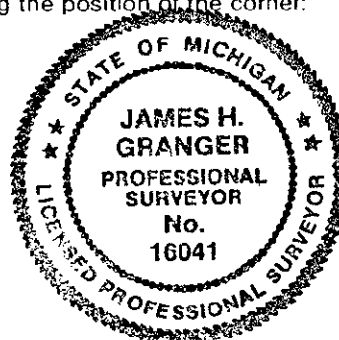

Signed by James H. Granger Date November 10, 1994

Surveyor's Michigan License No. 16041