

**SURVEY & REMONUMENTATION**

APR 27 1995

**COMMISSION**

**IOSCO COUNTY REMONUMENTATION CORNER  
LAND CORNER RECORDATION CERTIFICATE  
Filing Requirement of Act 74, Mich. P.A. 1970**

STATE OF MICHIGAN  
IOSCO COUNTY  
FILED

15 NOV 94 4:02 P.M.

BONITA H. COYLE  
REGISTER OF DEEDS

94-09

Register of Deeds Stamp & File Number

For corners in

| Iosco<br>(County)                     | Located In:              | Corner Code # |
|---------------------------------------|--------------------------|---------------|
| 1. Public Land Survey                 | T <u>22N</u> R <u>8E</u> | <u>H - 7</u>  |
|                                       | T _____ R _____          | _____         |
|                                       | T _____ R _____          | _____         |
|                                       | T _____ R _____          | _____         |
| 2. Property Controlling<br>in Section | S _____ T _____ R _____  | _____         |
|                                       | S _____ T _____ R _____  | _____         |
| 3. Miscellaneous<br>Property in Sec.  | S _____ T _____ R _____  | _____         |
|                                       | S _____ T _____ R _____  | _____         |

4. Lot No. \_\_\_\_\_, Recorded Plat \_\_\_\_\_  
5. Private Claims \_\_\_\_\_

I, James H. Granger, in a field survey on September, 19 94, do hereby certify that under requirements of P.A. 74, Michigan P.A. of 1970, the corner points mentioned in lines 1 and 2 above were in conformance with regulations and rules therefore as required in the current manual of survey instructions of the United States Department of the Interior, Bureau of Land Management or by a decree of a Court of Law and/or that the corner points mentioned in lines 3, 4 and 5 above were in conformance with the rules of the Michigan Board of Land Surveyors or by a Decree of a Court of Law; established, re-established, monumented, re-monumented, recovered, found as expressed below:

**NOTE: Not more than 4 corners, all in the same town and range, may be recorded on this certificate.**

|    | A  | B | C  | D | E  | F | G  | H | I  | J | K  | L | M |
|----|----|---|----|---|----|---|----|---|----|---|----|---|---|
| 2  | 6  |   | 5  |   | 4  |   | 3  |   | 2  |   | 1  |   |   |
| 3  |    |   |    |   |    |   |    |   |    |   |    |   |   |
| 4  | 7  |   | 8  |   | 9  |   | 10 |   | 11 |   | 12 |   |   |
| 5  |    |   |    |   |    |   |    |   |    |   |    |   |   |
| 6  | 18 |   | 17 |   | 16 |   | 15 |   | 14 |   | 13 |   |   |
| 7  |    |   |    |   |    |   |    | ● |    |   |    |   |   |
| 8  | 19 |   | 20 |   | 21 |   | 22 |   | 23 |   | 24 |   |   |
| 9  |    |   |    |   |    |   |    |   |    |   |    |   |   |
| 10 | 30 |   | 29 |   | 28 |   | 27 |   | 26 |   | 25 |   |   |
| 11 |    |   |    |   |    |   |    |   |    |   |    |   |   |
| 12 | 31 |   | 32 |   | 33 |   | 34 |   | 35 |   | 36 |   |   |
| 13 |    |   |    |   |    |   |    |   |    |   |    |   |   |

A. Description of original monument and accessories and/or subsequent restoration:

|                      |                              |
|----------------------|------------------------------|
| 1843 Original Survey | Set Wood Post                |
| John Mullett         | 10" Spruce Pine S65°E 38 lks |
|                      | 8" Spruce Pine N62°W 17 lks  |
| 1958 Sub'd           | N. Tawas Center No. 1        |
| 1974 Survey          | Monument                     |

B. Description of corner evidence found and/or method applied in restoring or reestablishing corner:  
Found conc. mon. as previously established. Accepted position.


ACCEPTED BY THE IOSCO COUNTY  
SURVEY PEER GROUP AS THE  
OFFICIAL CORNER UNDER P.A.  
345 OF 1990 AT A MEETING  
HELD ON 10-10-94

*James H. Granger*

C. Description of monument for corner and accessories established to perpetuate locating the position of the corner:

Concrete mon. with alum. cap

- 10" White Pine N 17.11' Fnd Nail & Ribbon
- 8" White Pine N80°E 23.18' Fnd Nail & Ribbon
- 14" Jack Pine S15°W 14.02' Fnd Nail & Ribbon
- 16" Red Pine S80°W 13.90' Fnd Nail & Ribbon

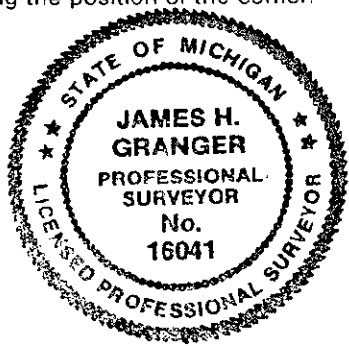

Signed by James H. Granger Date November 10, 1994  
Surveyor's Michigan License No. 16041