IOSCO COUNTY REMONUMENTATION
LAND CORNER RECORDATION CERTIFICATE
Filing Requirement of Act 74, Mich. P.A. 1970

95-23

STATE OF MICHIGAN
IOSCO COUNTY
FILED

12 DEC 95 2:23 P.M.

BONITA M. COYLE
REGISTER OF DEEDS
Register of Deeds Stamp & File Number

or corners in

IOSCO
(County)

	Located In:		Corner Code #
_ Public Land Survey		T22N R8E	I-6
		T___ R___	
		T___ R___	
		T___ R___	Seq. #1
_ Property Controlling	S___	T___ R___	
in Section	S___	T___ R___	
. Miscellaneous	S___	T___ R___	
Property in Sec.	S___	T___ R___	

-. Lot No. _____, Recorded Plat _____
. Private Claims _____

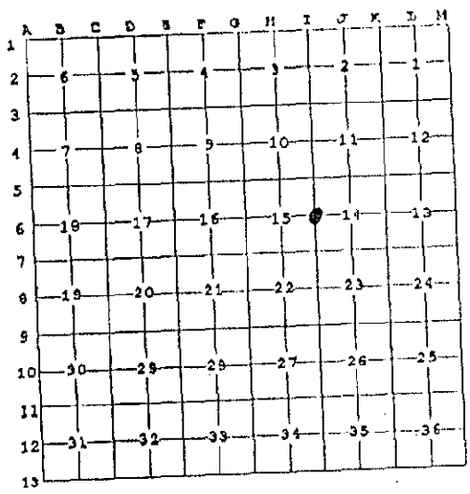

_ James H. Granger _____, in a field survey on November 3 _____, 19 95 do hereby state that under equirements of P.A. 74, Michigan P.A. of 1970, the corner points mentioned in lines 1 and 2 above were in conformance with regulations and rules therefore as required in the current manual of survey instructions of he United States Department of the Interior, Bureau of Land Management or by a decree of a Court of Law and /or that the corner points mentioned in lines 3, 4 and 5 above were in conformance with the rules of the Michigan Board of Land Surveyors or by a Decree of a Court of Law; established, re-established, monumented, recovered, found as expressed below:

NOTE: Not more than 2 corners, all in the same town and range, may be recorded on this certificate.

A. Description of original monument and accessories and/or subsequent restoration:

1837 Original Survey — Wood Post, 14" G. Pine — S57°W 124 lks.

B. Description of corner evidence found and/or method applied in restoring or reestablishing corner:

No evidence found on original corner.
Re-establised by single proporionate meaurement between NW and SW Sec. Corers

ACCEPTED BY THE IOSCO COUNTY SURVEY PEER GROUP AS THE OFFICIAL CORNER UNDER P.A. 345 OF 1990 AT A MEETING HELD ON 10-31-95
James H Granger

C. Description of monument for corner and accessories established to perpetuate locating the position of the corner:

5/8" x 30" Rebar with aluminium cap

PP	West	61.10'	set nail and tag
24" Triple Birch	South	53.37'	set nail and tag
10" Jack Pine	S75°E	62.21'	set nail and tag
6" Oak	N25°E	23.30'	set nail and tag

STATE OF MICHIGAN
JAMES H. GRANGER
PROFESSIONAL SURVEYOR
No. 16041
LICENSED PROFESSIONAL SURVEYOR

Signed by James H Granger
Date December 6, 1995
Surveyor's Michigan License No. 16041

FORM APPROVED BY MICHIGAN STATE BOARD OF PROFESSIONAL SURVEYORS, JAN. 28, 1971
REVISED MAY 14, 1975
REVISED JAN., 1983
REVISED OCT., 1995