

FEB 27 1996

IOSCO COUNTY REMONUMENTATION
LAND CORNER RECORDATION CERTIFICATE
Filing Requirement of Act 74, Mich. P.A. 1970

95-24

For corners in COMMISSION

<u>IOSCO</u> (County)	Located In:	Corner Code #
1. Public Land Survey	<u>T22N R 8E</u>	<u>J-5</u>
	T ___ R ___	_____
	T ___ R ___	_____
	T ___ R ___	_____
2. Property Controlling in Section	S ___ T ___ R ___	_____
	S ___ T ___ R ___	_____
3. Miscellaneous Property in Sec.	S ___ T ___ R ___	_____
	S ___ T ___ R ___	_____

STATE OF MICHIGAN
IOSCO COUNTY
FILED


12 DEC 95 2:23 P.M.

RENITA H. COYLE
REGISTER OF DEEDS

Register of Deeds Stamp & File Num

4. Lot No. _____, Recorded Plat _____
5. Private Claims _____

I, James H. Granger, in a field survey on November 7, 19 95 do hereby state that under requirements of P.A. 74, Michigan P.A. of 1970, the corner points mentioned in lines 1 and 2 above were in conformance with regulations and rules therefore as required in the current manual of survey instructions of the United States Department of the Interior, Bureau of Land Management or by a decree of a Court of Law and for that the corner points mentioned in lines 3, 4 and 5 above were in conformance with the rules of the Michigan Board of Land Surveyors or by a Decree of a Court of Law, established, re-established, monumented, recovered, found as expressed below:

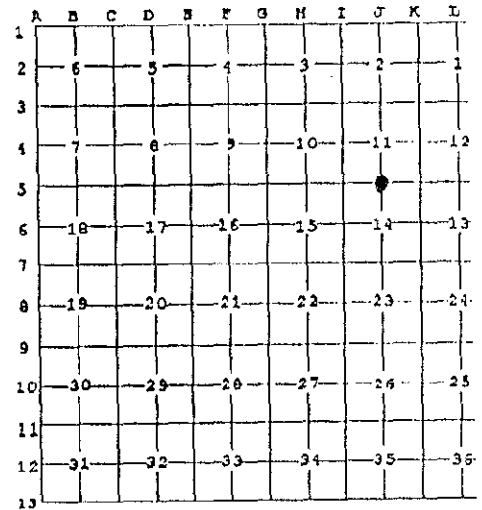

NOTE: Not more than 2 corners, all in the same town and range, may be recorded on this certificate.

A. Description of original monument and accessories and/or subsequent restoration:

1837 Original Survey	Wood Post	
	6" Spruce Pine	N46°E 14 lks.
	8" Spruce Pine	S05°W 23 lks
1979 Private Survey	found 3/4" pipe	

B. Description of corner evidence found and/or method applied in restoring or reestablishing corner:

Found 2" pipe with 1/2" rebar insert. Position agreed with previous survey of 1979.


ACCEPTED BY THE IOSCO COUNTY
SURVEY PEER GROUP AS THE
OFFICIAL CORNER UNDER P.A.
345 OF 1990 AT A MEETING
HELD ON 10-31-95

James H. Granger

C. Description of monument for corner and accessories established to perpetuate locating the position of the corner:

5/8" x 30" Rebar inside 2" pipe with aluminium cap

6" Jack Pine	S20°E	40.14'	set nail and tag
Fence Post	N20°W	43.87'	set nail and tag
6" Jack Pine	N30°E	80.46'	set nail and tag
6" Jack Pine	N65°W	99.27'	set nail and tag

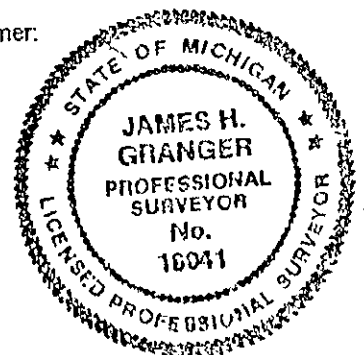

Signed by James H. Granger
Surveyor's Michigan License No. 16041

Date December 6, 1995