

SURVEY & REMONUMENTATION

APR 27 1995

COMMISSION

IOSCO COUNTY REMONUMENTATION CORNER LAND CORNER RECORDATION CERTIFICATE Filing Requirement of Act 74, Mich. P.A. 1970

STATE OF MICHIGAN
IOSCO COUNTY
FILED

5 DEC 94 1:56 P.M.

BONITA H. COYLE
REGISTER OF DEEDS

94-27

Register of Deeds Stamp & File Number

For corners in

_____ (County)	Located In:	Corner Code ##
1. Public Land Survey	T <u>22N</u> R <u>8E</u>	<u>I - 7</u>
	T _____ R _____	_____
	T _____ R _____	_____
	T _____ R _____	_____
2. Property Controlling in Section	S _____ T _____ R _____	_____
	S _____ T _____ R _____	_____
3. Miscellaneous Property in Sec.	S _____ T _____ R _____	_____
	S _____ T _____ R _____	_____

4. Lot No. _____, Recorded Plat _____
5. Private Claims _____

	A	B	C	D	E	F	G	H	I	J	K	L	M
2	6		5		4		3		2		1		
3													
4	7		8		9		10		11		12		
5													
6	18		17		16		15		14		13		
7													
8	19		20		21		22		23		24		
9													
10	30		29		28		27		26		25		
11													
12	31		32		33		34		35		36		
13													

I, James H. Granger, in a field survey on September, 19 94, do hereby certify that under requirements of P.A. 74, Michigan P.A. of 1970, the corner points mentioned in lines 1 and 2 above were in conformance with regulations and rules therefore as required in the current manual of survey instructions of the United States Department of the Interior, Bureau of Land Management or by a decree of a Court of Law and/or that the corner points mentioned in lines 3, 4 and 5 above were in conformance with the rules of the Michigan Board of Land Surveyors or by a Decree of a Court of Law; established, re-established, monumented, re-monumented, recovered, found as expressed below:

NOTE: Not more than 4 corners, all in the same town and range, may be recorded on this certificate.

- A. Description of original monument and accessories and/or subsequent restoration:
- 1843 Original Survey 10" Maple for corner
John Mullett
 - 1949 Sub'd Crocker's Deer Park
 - 1949 Sub'd Woodland Park
 - 1979 Survey Conc. mon.

- B. Description of corner evidence found and/or method applied in restoring or reestablishing corner:
Found conc. mon. as previously recorded. Accepted position as established.


ACCEPTED BY THE IOSCO COUNTY
SURVEY PEER GROUP AS THE
OFFICIAL CORNER UNDER P.A.
345 OF 1990 AT A MEETING
HELD ON 11-10-94

James H. Granger

- C. Description of monument for corner and accessories established to perpetuate locating the position of the corner:

Set 5/8" bar w/alum. cap inside 1" pipe encased in concrete

- N40°E 7.95' Set tag in 8" white pine
- S80°E 33.34' Conc. mon.
- S70°E 36.63' Set tag in 6" cedar
- N65°E 69.68' Set tag in 12" maple

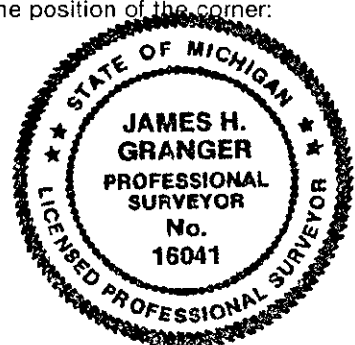

Signed by James H. Granger Date November 10, 1994
Surveyor's Michigan License No. 16041