

SURVEY & REMONUMENTATION

APR 27 1995

COMMISSION

IOSCO COUNTY REMONUMENTATION CORNER LAND CORNER RECORDATION CERTIFICATE Filing Requirement of Act 74, Mich. P.A. 1970

STATE OF MICHIGAN
IOSCO COUNTY
FILED

For corners in

15 NOV 94 4:01 P.M.

BONITA H. COYLE
REGISTER OF DEEDS

94-06

Register of Deeds Stamp & File Number

Iosco (County)	Located In:	Corner Code #
1. Public Land Survey	T <u>22N</u> R <u>8E</u>	<u>K - 5</u>
	T _____ R _____	_____
	T _____ R _____	_____
	T _____ R _____	_____
2. Property Controlling in Section	S _____ T _____ R _____	_____
	S _____ T _____ R _____	_____
3. Miscellaneous Property in Sec.	S _____ T _____ R _____	_____
	S _____ T _____ R _____	_____

4. Lot No. _____, Recorded Plat _____
5. Private Claims _____

	A	B	C	D	E	F	G	H	I	J	K	L	M
2	6		5		4		3		2		1		
3													
4	7		8		9		10		11		12		
5													
6	18		17		16		15		14		13		
7													
8	19		20		21		22		23		24		
9													
10	30		29		28		27		26		25		
11													
12	31		32		33		34		35		36		
13													

I, James H. Granger, in a field survey on September, 19 94, do hereby certify that under requirements of P.A. 74, Michigan P.A. of 1970, the corner points mentioned in lines 1 and 2 above were in conformance with regulations and rules therefore as required in the current manual of survey instructions of the United States Department of the Interior, Bureau of Land Management or by a decree of a Court of Law and/or that the corner points mentioned in lines 3, 4 and 5 above were in conformance with the rules of the Michigan Board of Land Surveyors or by a Decree of a Court of Law; established, re-established, monumented, re-monumented, recovered, found as expressed below:

NOTE: Not more than 4 corners, all in the same town and range, may be recorded on this certificate.

A. Description of original monument and accessories and/or subsequent restoration:

1843 Original Survey	Set Wood Post
John Mullett	8" Spruce Pine S72°E 4 lks
	6" Spruce Pine S70°W 4 lks
1979 Survey	Conc. Mon.

B. Description of corner evidence found and/or method applied in restoring or reestablishing corner:


Found 4" conc. mon with 1/2" ID pipe encased in steel pipe. Accepted position as previously established.

ACCEPTED BY THE IOSCO COUNTY
SURVEY PEER GROUP AS THE
OFFICIAL CORNER UNDER P.A.
365 OF 1990 AT A MEETING
HELD ON 10-10-94

James H. Granger

C. Description of monument for corner and accessories established to perpetuate locating the position of the corner:

1/2" rebar inside a 1/2" I.D. pipe encased in conc. encased in steel pipe with alum. cap
12" Oak S5°E 16.49' Set Nail & Tag
Power Pole S46°E 49.43' Set Nail & Tag
10" Oak N6°E 47.34' Set Nail & Tag
Inscribed "x" on N. side of galvanized fence post S84°W 19.84'

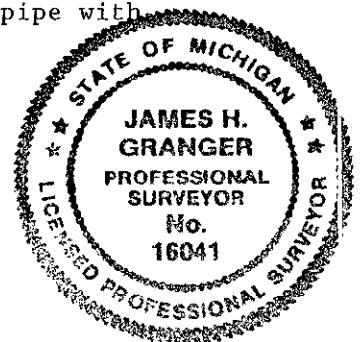

Signed by James H. Granger Date November 10, 1994
Surveyor's Michigan License No. 16041