

**SURVEY & REMONUMENTATION**

APR 27 1995

**COMMISSION**

**IOSCO COUNTY REMONUMENTATION CORNER  
LAND CORNER RECORDATION CERTIFICATE  
Filing Requirement of Act 74, Mich. P.A. 1970**

STATE OF MICHIGAN  
IOSCO COUNTY  
FILED

5 DEC 94 1:53 P.M.

BONITA M. COYLE  
REGISTER OF DEEDS

**94-20**

Register of Deeds Stamp & File Number

For corners in

<u>Iosco</u> (County)	Located In:	Corner Code #
1. Public Land Survey	T <u>22N</u> R <u>8E</u>	<u>K - 6</u>
	T _____ R _____	_____
	T _____ R _____	_____
	T _____ R _____	_____
2. Property Controlling in Section	S _____ T _____ R _____	_____
	S _____ T _____ R _____	_____
3. Miscellaneous Property in Sec.	S _____ T _____ R _____	_____
	S _____ T _____ R _____	_____

4. Lot No. \_\_\_\_\_, Recorded Plat \_\_\_\_\_  
5. Private Claims \_\_\_\_\_

	A	B	C	D	E	F	G	H	I	J	K	L	M
2	6		5		4		3		2		1		
3													
4	7		8		9		10		11		12		
5													
6	18		17		16		15		14		13		
7													
8	19		20		21		22		23		24		
9													
10	30		29		28		27		26		25		
11													
12	31		32		33		34		35		36		
13													

I, James H. Granger, in a field survey on September, 19 94, do hereby certify that under requirements of P.A. 74, Michigan P.A. of 1970, the corner points mentioned in lines 1 and 2 above were in conformance with regulations and rules therefore as required in the current manual of survey instructions of the United States Department of the Interior, Bureau of Land Management or by a decree of a Court of Law and/or that the corner points mentioned in lines 3, 4 and 5 above were in conformance with the rules of the Michigan Board of Land Surveyors or by a Decree of a Court of Law; established, re-established, monumented, re-monumented, recovered, found as expressed below:


**NOTE: Not more than 4 corners, all in the same town and range, may be recorded on this certificate.**

A. Description of original monument and accessories and/or subsequent restoration:  
1843 Original Survey Set Wood Post  
John Mullett 6" Cedar N74°W 7 lks  
8" W. Birch S31°E 26 lks

B. Description of corner evidence found and/or method applied in restoring or reestablishing corner:  
Located cor. K-7 and ex. mon. in Deer Park Sub'd to establish W. sec. line. Sub'd is 1/4 mile along sec. line. Extended sec. line N. and doubled sub'd measurement. Position ended at old wood post. Single proportionate distance indicates 60' difference between N. & S. halves. Search at exact midway location revealed nothing. Accepted old wood post due to close agreement with sub'd distance doubled.

ACCEPTED BY THE IOSCO COUNTY SURVEY PEER GROUP AS THE OFFICIAL CORNER UNDER P.A. 345 OF 1990 AT A MEETING HELD ON 11-10-94  
*James H. Granger*

C. Description of monument for corner and accessories established to perpetuate locating the position of the corner:  
Set 5/8" x 30" rebar with alum. cap  
S40°W 6.86' 8" Cedar  
S40°E 13.58' 12" double Ash  
East 6.77' 10" Maple  
N10°E 69.45' 18" Cedar

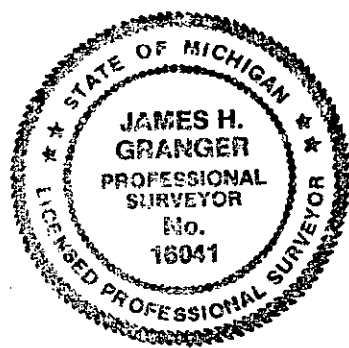

Signed by James H. Granger Date November 10, 1994  
Surveyor's Michigan License No. 16041