

SURVEY & REMONUMENTATION

APR 27 1995

COMMISSION

IOSCO COUNTY REMONUMENTATION CORNER LAND CORNER RECORDATION CERTIFICATE

Filing Requirement of Act 74, Mich. P.A. 1970

STATE OF MICHIGAN
IOSCO COUNTY
FILED

5 DEC 94 1:55 P.M.

BONITA M. COYLE
REGISTER OF DEEDS

94-26

Register of Deeds Stamp & File Number

For corners in

Iosco (County)	Located In:	Corner Code #
1. Public Land Survey	T <u>22N</u> R <u>8E</u>	<u>M - 5</u>
	T _____ R _____	_____
	T _____ R _____	_____
	T _____ R _____	_____
2. Property Controlling in Section	S _____ T _____ R _____	_____
	S _____ T _____ R _____	_____
3. Miscellaneous Property in Sec.	S _____ T _____ R _____	_____
	S _____ T _____ R _____	_____
4. Lot No. _____, Recorded Plat _____		
5. Private Claims _____		

I, James H. Granger, in a field survey on September, 19 94, do hereby certify that under requirements of P.A. 74, Michigan P.A. of 1970, the corner points mentioned in lines 1 and 2 above were in conformance with regulations and rules therefore as required in the current manual of survey instructions of the United States Department of the Interior, Bureau of Land Management or by a decree of a Court of Law and/or that the corner points mentioned in lines 3, 4 and 5 above were in conformance with the rules of the Michigan Board of Land Surveyors or by a Decree of a Court of Law; established, re-established, monumented, re-monumented, recovered, found as expressed below:

NOTE: Not more than 4 corners, all in the same town and range, may be recorded on this certificate.

A. Description of original monument and accessories and/or subsequent restoration:

1837 Original Survey	Set Wood Post	1963	Sub'd	Avalon Woods
Lewis Clasen	4" Spruce Pine N43°W 82 lks	1963	Sub'd	Wood-lon Beach
	14" Yellow Pine S58°W 150 lks	1963	Sub'd	Lixey Park No. 1
1930 MDOT	4" boiler flue			
1931 Sub'd	Avalon Beach			
1940 Sub'd	Woodland Beach			
1962 MDOT	4" boiler flue			

B. Description of corner evidence found and/or method applied in restoring or reestablishing corner:

Found monument as previously established. Accepted position as found.


ACCEPTED BY THE IOSCO COUNTY
SURVEY PEER GROUP AS THE
OFFICIAL CORNER UNDER P.A.
345 OF 1990 AT A MEETING
HELD ON 11-10-94

James H. Granger

C. Description of monument for corner and accessories established to perpetuate locating the position of the corner:

Set 5/8" bar w/alum. cap inside 1" pipe encased in concrete

S55°W	15.31'	10"	Oak
N10°W	32.34'	14"	W. Pine
S05°E	12.37'	8"	W. Pine
N35°E	13.83'	4"	W. Pine

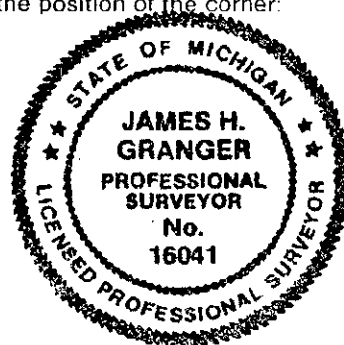

Signed by James H. Granger Date November 10, 1994

Surveyor's Michigan License No. 16041