

**REMONUMENTATION CORNER
LAND CORNER RECORDATION CERTIFICATE
Filing Requirement of Act 74, Mich. P.A. 1970**

For corners in

Iosco
(County)

Located In:

Corner Code #

- | | | |
|---------------------------------------|---|---------------|
| 1. Public Land Survey | T <u>22N</u> R <u>R8E</u> | <u>1-6</u> |
| | T <u> </u> R <u> </u> | <u> </u> |
| | T <u> </u> R <u> </u> | <u> </u> |
| | T <u> </u> R <u> </u> | <u> </u> |
| 2. Property Controlling
in Section | S <u> </u> T <u> </u> R <u> </u> | <u>Seg #2</u> |
| | S <u> </u> T <u> </u> R <u> </u> | <u> </u> |
| 3. Miscellaneous
Property in Sec. | S <u> </u> T <u> </u> R <u> </u> | <u> </u> |
| | S <u> </u> T <u> </u> R <u> </u> | <u> </u> |

STATE OF MICHIGAN
IOSCO COUNTY
FILED

8 DEC 97 2:58 P.M.

BONITA M. COYLE
REGISTER OF DEEDS

97-68

Register of Deeds Stamp & File Number

4. Lot No. _____, Recorded Plat _____
5. Private Claims _____

I, James H. Granger, in a field survey on November 19, 1997 do hereby state that under requirements of P.A. 74, Michigan P.A. of 1970, the corner points mentioned in lines 1 and 2 above were in conformance with regulations and rules therefore as required in the current manual of survey instructions of the United States Department of the Interior, Bureau of Land Management or by a decree of a Court of Law and for that the corner points mentioned in lines 3, 4 and 5 above were in conformance with the rules of the Michigan Board of Land Surveyors or by a Decree of a Court of Law; established, re-established, monumented, recovered, found as expressed below:

NOTE: Not more than 2 corners, all in the same town and range, may be recorded on this certificate.

THIS LCRC REPLACES A PREVIOUS LCRC AS RECORDED IN L 95, P 23

	A	B	C	D	E	F	G	H	I	J	K	L	M
1													
2		6		5		4		3		2		1	
3													
4		7		8		9		10		11		12	
5													
6		18		17		16		15		14		13	
7													
8		19		20		21		22		23		24	
9													
10		30		29		28		27		26		25	
11													
12		31		32		33		34		35		36	
13													

A. Description of original monument and accessories and/or subsequent restoration:

- | | | | | |
|------|------------------------|--------------------------|--------|---------|
| 1837 | Original Survey | Wood Post
14" G. Pine | S 57°W | 124 lks |
| 1997 | William Rigg
#41108 | 1/2" rebar & cap | | |

ACCEPTED BY THE IOSCO COUNTY
SURVEY PEER GROUP AS THE
OFFICIAL CORNER UNDER P.A.
345 OF 1990 AT A MEETING
HELD ON 11-19-97

James H. Granger


B. Description of corner evidence found and/or method applied in restoring or reestablishing corner:

Projected sec. line between SE & NE cors of North Ridge #1. Confirmed position as established in LCRC recorded in L 97 P 24 by William Rigg.

C. Description of monument for corner and accessories established to perpetuate locating the position of the corner:

Set 5/8" x 30" Rebar with aluminum cap

- | | | | |
|--------------|--------|--------|--------------------|
| Utility Pole | S 83°W | 30.96' | nail & tag # 16041 |
| 6" wood post | N 32°W | 39.82' | nail & tag # 16041 |
| 2" Spruce | N 55°E | 31.06' | nail & tag # 16041 |
| 6" Jack Pine | S 49°E | 18.86' | nail & tag # 16041 |

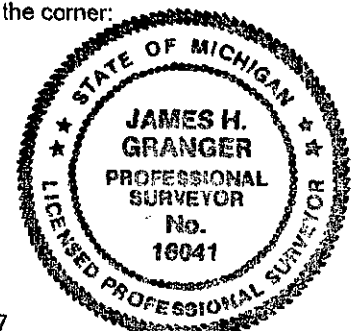

Signed by James H. Granger
Surveyor's Michigan License No. 16041

Date Dec. 8, 1997